IREDELL COUNTY HEALTH DEPARTMENT

STATESVILLE 704-878-5305 MOORESVILLE 704-664-5281

IMPROVEMENT PERMIT / AUTHORIZATION TO CONSTRUCT / OPERATION PERMIT / EXISTING SYSTEM INSPECTION

PERMIT# 139323 PIN# 4626581913.571 4626-57-4492 DATE 6-22-07

OWNER OR APPLICANT The Hoke Company PHONE: Business 799-7495 Home

ADDRESS P.O. Box 4448 Mooresville, NC 28117

LOCATION Brawley School Rd TR McKendree TR Grasshopper TR Cherry Tree Dr on right

SUBDIVISION The Farms BLOCK / SECTION 5 LOT 57 LOT AREA .97 Acre SITE CLASS. PS DESIGN FLOW 600gpd L.T.A.R. .25

Septic Tank: 1500 Gallons; STB 338 Date 4-15-07
Pump Tank: 1500 Gallons; PT 477 Date 7-1-07
Pump Make: Myers Model ME50 Serial No.
Nitrification Field: No fields 1 Square Feet 1200 Linear Feet 400'
No Lines 4 Trench Width ~~As Soil Cat~~ Max Trench Bottom Depth 36" Gravel Depth N/A ☐ Gravity ☒ Pressure ☐ Slab ☒ Crawl Space ☐ Basement w/plumbing ☐ Basement wo/plumbing

☒ New System ☐ Repair ☐ Expansion System Type: I II III IV V VI
System Description: LP - Panel Block
Repair System Description: Same
Maintenance Agreement Required: ☐ Yes ☐ No

☒ House/Mod. Home No. Bedrooms 5
☐ Mobile Home No. Persons
☐ Business No. Employees
☐ Other


Water Supply: ☐ Individual ☒ Public ☒ Community

Comments/Conditions: Note: Use trench width specified in Crescent Communities Manuel


Scale 1:50 CVB

Comments/Conditions: Must keep any future pool 15ft from pool "cut"
Installed 4 lines @ 100ft eq.
9/7/07 Checked tanks & lines

INITIAL SITE SKETCH

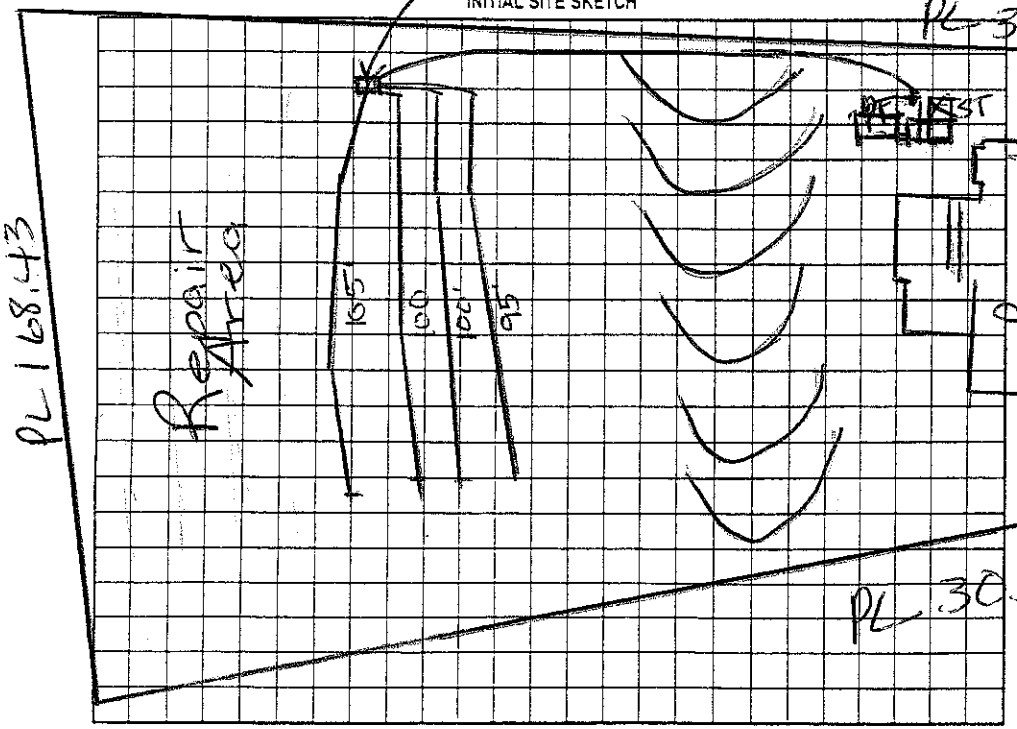

AS BUILT SKETCH

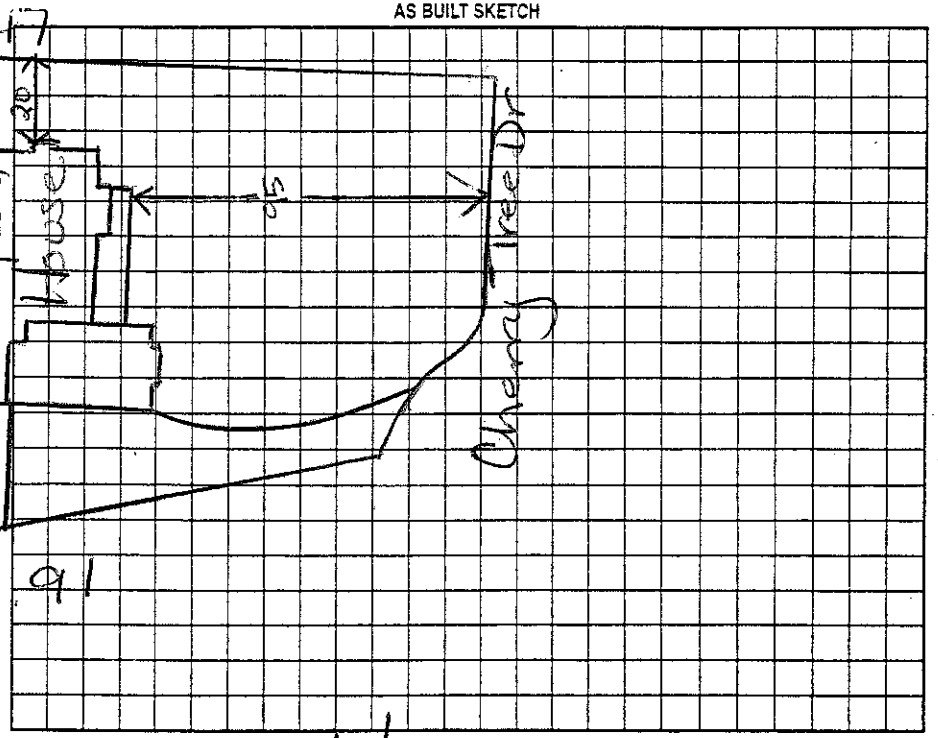

Permit can be suspended or revoked if any false information is supplied toward securing the permit/any unauthorized changes are made to the site/any unauthorized changes are made in the installation of the system. Improvement Permit with plat valid without expiration ☐ Improvement Permit with site plan valid for sixty months ☐ Authorization to Construct is valid for a period equal to that of Improvement Permit – not to exceed sixty months.

Signed: Darrell Hoke date 6/22/07 Installed by: K. Hall RS

Improvement Permit by: Marian H. Dotson RS date 6/22/07 Operation Permit by: Marian H. Dotson RS date 12/10/07

Authorization to Construct by: Marian H. Dotson RS date 6/22/07 Existing System Inspection by: date

HEALTH DEPT. COPY: WHITE OWNER COPY (FINAL): YELLOW OWNER COPY (INITIAL): PINK