HEALTH DEPARTMENT - *ENVIRONMENTAL HEALTH* ☐ STATESVILLE OFFICE 704-878-5305 ☑ ~~MOO~~RESVILLE OFFICE 704-664-5281

IMPR[illegible] PERMIT / AUTHORIZATION TO CONSTRUCT / OPERATION PERMIT / EXISTING SYSTEM INSPECTION

PERMIT # 159338 PIN # 4626-57-4958 DATE 3-5-12

OWNER MI Homes APPLICANT: SAME PHONE: Home/Cell # 704-402-7882 Business #

SITE ADDRESS 106 Bellsford Court OWNER / APPLICANT ADDRESS 9335 Harris Corners Pkwy Ch. NC 28269

SITE DIRECTIONS BSR, TR McKendree, TR Grasshopper, TR Cherry Tree, on L

SUBDIVISION Time Farms BLOCK / SECTION 5 LOT # 581 LOT AREA .76 AC DESIGN FLOW 480 L.T.A.R. .75

Septic Tank 1500 Gallons: STB 444 Date 11-30-11

Pump Tank ___ Gallons: P T ___ Date ___

Pump Make ___ Model ___ Serial # ___

No. Nitrification Field 1 No. Lines 12 Linear Feet 480'

Trench Width 36" Max. Trench Bottom Depth 36" Gravel Depth ___

☑ New System ☐ Repair ☐ Expansion System Type I II III IV V VI

System Description: 25% Reduction

Repair System Description: LP - Panel Block

Maintenance Agreement Required ☐ YES ☑ ~~NO~~

☑ GRAVITY ☐ PRESSURE

☑ Residence No. Bedrooms 4

☐ Business No. Persons ___

☐ Other No. Employees ___

☐ Slab ☑ Crawl Space


☐ Basement w/plumbing ☐ Basement w/o plumbing

Water Supply: ☐ Private ☐ Public ☑ ~~Community~~

Comments / Conditions

① STAY 5' from FOUNDATION

INITIAL SITE SKETCH

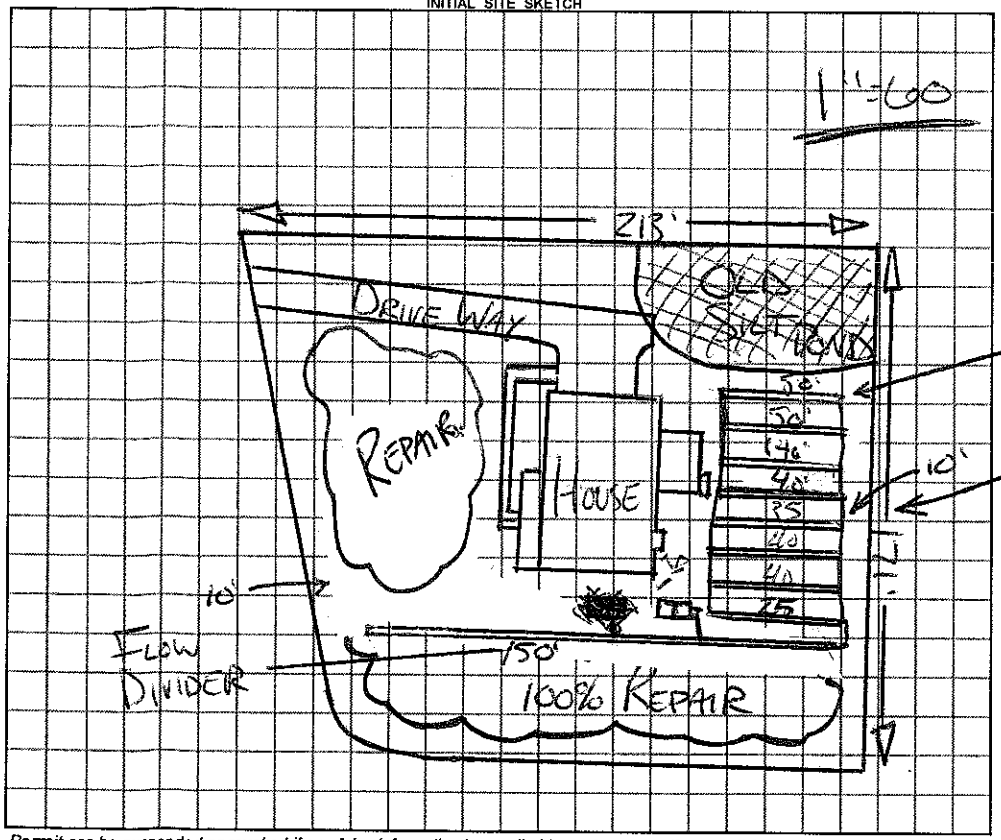

AS BUILT SKETCH

* Lines Close To Stairs can be shortened as long as lost footage is made up on other lines

40' Lines Fed from This End

*

Permit can be suspended or revoked if any false information is supplied toward securing the permit / any unauthorized changes are made to the site / any unauthorized changes are made in the installation of the system.

☐ ***IMPROVEMENT PERMIT*** with plat valid without expiration. ☐ ***IMPROVEMENT PERMIT*** with plat ~~valid without expiration~~. site plan valid 60 mo. ☑ ***AUTHORIZATION TO CONSTRUCT*** valid for period equal to IMPROVEMENT PERMIT--not to exceed 60 mo.

Owner / Applicant Signature: [signature] Date 3-5-12 Installed by: Abernathy

IMPROVEMENT PERMIT by: [signature] ***REHS*** Date 3-5-12 OPERATION PERMIT by: [signature] ***REHS*** Date 6-5-12

AUTHORIZATION TO CONSTRUCT by: [signature] ***REHS*** Date 3-5-12 Existing System Inspected by: ___ ***REHS*** Date ___

YOU SHOULD CONTACT A LOCATOR SERVICE PRIOR TO ANY EXCAVATION

White Copy -- Environmental Health YELLOW COPY (Final) Owner / Applicant PINK COPY (Initial) Owner / Applicant