(173814)

IREDELL COUNTY HEALTH DEPARTMENT

STATESVILLE 704-878-5305 MOORESVILLE 704-664-5281

IMPROVEMENT PERMIT / AUTHORIZATION TO CONSTRUCT / OPERATION PERMIT / EXISTING SYSTEM INSPECTION

PERMIT # 139337 PIN # 4626581913.580 DATE 6/29/12

OWNER or APPLICANT MI HOMES PHONE: Business 704-402-7882 Home:

OWNER or APPLICANT ADDRESS 5350 77 CENTER DR St # 100

LOCATION / DIRECTIONS BRAWLEY SCHOOL - TR McENDREE - TR GRASSHOPPER - TR CHERRY TREE - ON LT CORNER OF STAMFORD

SUBDIVISION THE FARMS BLOCK / SECTION 5 LOT # 580 LOT AREA .7AC DESIGN FLOW 480 GAD L.T.A.R. .3 gal/ft²

Septic Tank 1000 Gallons: STB 444 Date 9-23-11

Pump Tank 1000 Gallons: PT 253 Date 9-10-12

Pump Make Zoeller Model WE0312M Serial #

Nitrification Field No Fields 1 No Lines 4 Linear Feet 270

Trench Width 24" Max. Trench Bottom Depth 36" Gravel Depth N/A

☒ New System ☐ Repair ☐ Expansion System Type I II III (IV) V VI

System Description: LP PPBPS

Repair System Description: LP PPBPS

Maintenance Agreement Required ☒ YES ☐ NO

☐ GRAVITY ☒ PRESSURE

☒ Residence No. Bedrooms 4

☐ Business No. Persons 8

☐ Other No. Employees

☐ Slab ☒ Crawl Space

☐ Basement w/plumbing ☐ Basement w/o plumbing

Water Supply: ☐ Private ☐ Public ☒ Community


Comments / Conditions 11/19/12 Set 3 FT pressure

Comments / Conditions Drilled 5/33" hole Checked tanks & lines 10/26/2012

INITIAL SITE SKETCH

SEE MICHAEL ASSOCIATES ATHANAS & DRAWING ATTACHED

AS BUILT SKETCH

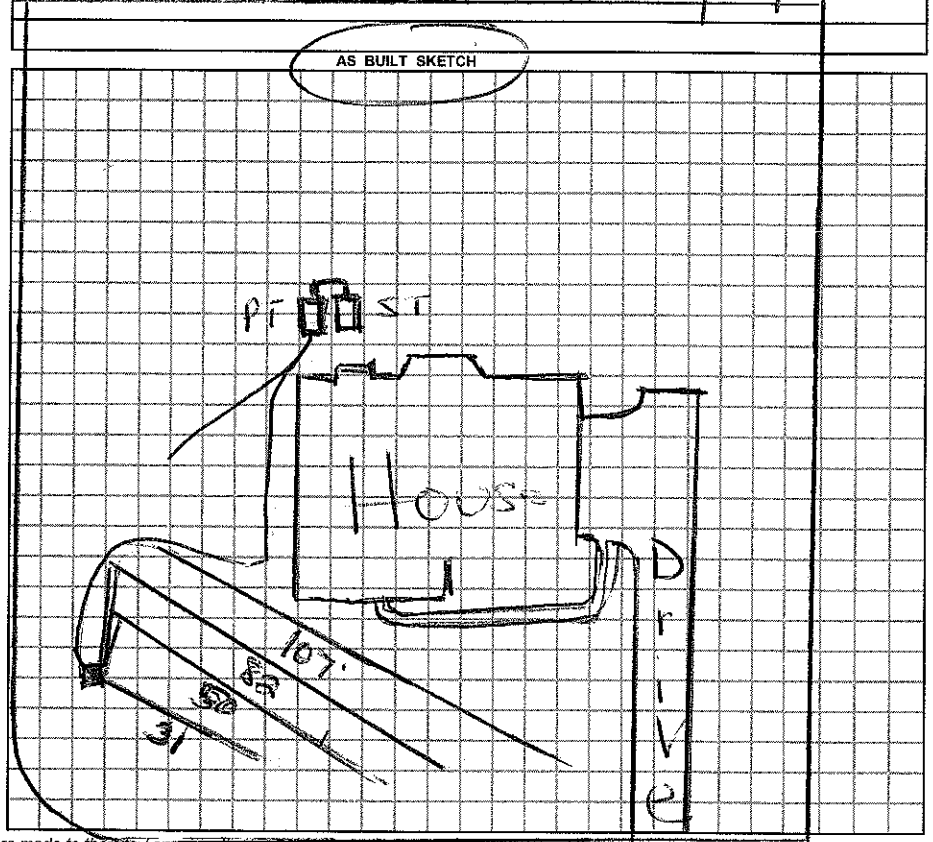

Permit can be suspended or revoked if any false information is supplied toward securing the permit / any unauthorized changes are made to the site / any unauthorized changes are made in the installation of the system.

☐ *IMPROVEMENT PERMIT w / plat valid without expiration.* ☒ *IMPROVEMENT PERMIT w / site plan valid for 60 mos.* ☐ *AUTHORIZATION TO CONSTRUCT valid for period equal to IMPROVEMENT PERMIT-not to exceed 60 mo.*

Owner / Applicant Signature: [signature] Date 7/3/12

Improvement Permit by: C. Brady Freeman Date 6/29/12

Authorzation to Construct by: C. Brady Freeman Date 7/3/12

Installed by: Richard Abernathy

Operation Permit by: [signature] Date: 11/19/12

Existing System Inspected by: Date:

YOU SHOULD CONTACT A LOCATOR SERVICE PRIOR TO ANY EXCAVATION.

WHITE COPY Environmental Health YELLOW COPY (Final) Owner / Applicant PINK COPY (Initial) Owner / Applicant