IREDELL COUNTY HEALTH DEPARTMENT - *ENVIRONMENTAL HEALTH* ☐ STATESVILLE OFFICE 704-878-5305 ☑ MOORESVILLE OFFICE 704-664-5281

IMPROVEMENT PERMIT / AUTHORIZATION TO CONSTRUCT / OPERATION PERMIT / EXISTING SYSTEM INSPECTION

PERMIT # 139332 PIN # 4626-57-8653 DATE 3-9-12

OWNER MI Homes / Paul Bo~~tt~~ APPLICANT: SAME PHONE: Home/Cell # 704-402-7882 Business #

SITE ADDRESS 141 CHERRY TREE DR. OWNER / APPLICANT ADDRESS 9335 HARRIS CORNERS PKWY

SITE DIRECTIONS BSR, MCKENDREE, GRASSHOPPER, CHERRY TREE ON L END

SUBDIVISION THE FARMS BLOCK / SECTION 5 LOT # 575 LOT AREA .74 AC DESIGN FLOW 600 GPD L.T.A.R. .75

Septic Tank 1500 Gallons: STB 447 Date 6-17-12 ☒ New System ☐ Repair ☐ Expansion System Type I II III (IV) V VI

Pump Tank 1500 Gallons: PT 444 Date 6-20-12 System Description: LP- PANEL BLOCK

Pump Make ____ Model ____ Serial # ____ Repair System Description: SAME

No. Nitrification Fields: 1 No. Lines 6 Linear Feet 400' Maintenance Agreement Required ☒ YES ☐ NO


Trench Width 36" Max. Trench Bottom Depth 36" Gravel Depth — ☐ GRAVITY ☒ PRESSURE

☒ Residence No. Bedrooms 5 ☐ Business No. Persons ____ ☐ Other No. Employees ____ ☐ Slab ☒ Crawl Space ☐ Basement w/plumbing ☐ Basement w/o plumbing

Water Supply: ☐ Private ☐ Public ☒ Community

Comments / Conditions

INITIAL SITE SKETCH

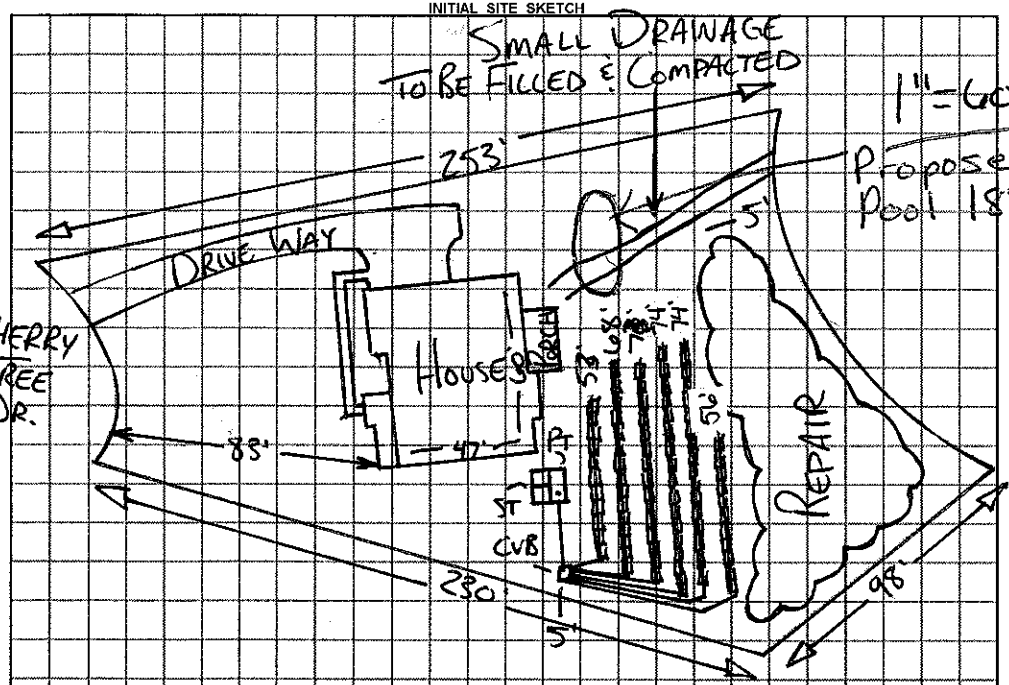

Bottom 3 LINES AS BUILT SKETCH

17, 17, 13 PANELS CHECKED 7-20-12

CHECKED OTHER LINES 7-24-12

CHECKED TANKS 7-24-12

The proposed / existing Inground Pool addition does not appear to impact the existing septic system.

**NOTE: Pool "cut" must be at least 15ft from Septic System

Maria Cotton R.S.

Date: 12/17/12

ICHD-Environmental Health Division

Permit can be suspended or revoked if any false information is supplied toward securing the permit / any unauthorized changes are made to the site / any unauthorized changes are made in the installation of the system.

☐ ***IMPROVEMENT PERMIT*** *with plat valid without expiration.* ☐ ***IMPROVEMENT PERMIT*** *with plat valid without expiration. site plan valid 60 mo.* ☒ ***AUTHORIZATION TO CONSTRUCT*** valid for period equal to IMPROVEMENT PERMIT--not to exceed 60 mo.

Owner / Applicant Signature: [signature] Date 3-9-12 Installed by: RICHARD ARERNATHY

IMPROVEMENT PERMIT by: [signature] REHS Date 3-9-12 OPERATION PERMIT by: [signature] REHS Date 8-28-12

AUTHORIZATION TO CONSTRUCT by: [signature] REHS Date 3-9-12 Existing System Inspected by: REHS Date

YOU SHOULD CONTACT A LOCATOR SERVICE PRIOR TO ANY EXCAVATION

White Copy – Environmental Health YELLOW COPY (Final) Owner / Applicant PINK COPY (Initial) Owner / Applicant