IREDELL COUNTY HEALTH DEPARTMENT

STATESVILLE 704-878-5305 MOORESVILLE 704-664-5281

IMPROVEMENT PERMIT / AUTHORIZATION TO CONSTRUCT / OPERATION PERMIT / EXISTING SYSTEM INSPECTION

PERMIT # 139664 PIN # 4626-58-4931 DATE 6-25-09

OWNER or APPLICANT Tim + MARIA HAYES PHONE: Business 336-345-3057 Home: 631-667-2421

OWNER or APPLICANT ADDRESS 96 HEIGHT STREET, BEER PARK NY 11729

LOCATION / DIRECTIONS BSR, TR McKEENDREE, TR GRASSHOPPER, TL BANTAM

SUBDIVISION THE FARMS BLOCK / SECTION 5 LOT # 565 LOT AREA 1.1 AC DESIGN FLOW 480 L.T.A.R. .3

Septic Tank 1500 Gallons: STB 338 Date 8-21-09
Pump Tank 1500 Gallons: PT 27 Date 1-25-10
Pump Make Zoeller Model WEO312MV Serial #
Nitrification Field No Fields 1 No Lines 4 Linear Feet 400'
Trench Width 36" Max. Trench Bottom Depth 36" Gravel Depth

☒ New System ☐ Repair ☐ Expansion System Type I II (III) IV V VI B
System Description: PM - 25% REDUCTION
Repair System Description: SAME
Maintenance Agreement Required ☐ YES ☒ NO
☐ GRAVITY ☒ PRESSURE


☒ Residence No. Bedrooms 4
☐ Business No. Persons 4
☐ Other No. Employees
☐ Slab ☒ Crawl Space
☐ Basement w/plumbing ☐ Basement w/o plumbing

Water Supply: ☐ Private ☐ Public ☒ Community


Comments / Conditions 1) MEET ALL SETBACKS 2) SOME GRADING MAY NEED TO BE DONE TO FILL IN SMALL LOW AREA IN DRAIN FIELD AREA

Comments / Conditions * Used Art. 36 3/9/00 Checked tanks & lines, 5/10/2010 Set 2ft pressure Checked float & alarm.

INITIAL SITE SKETCH

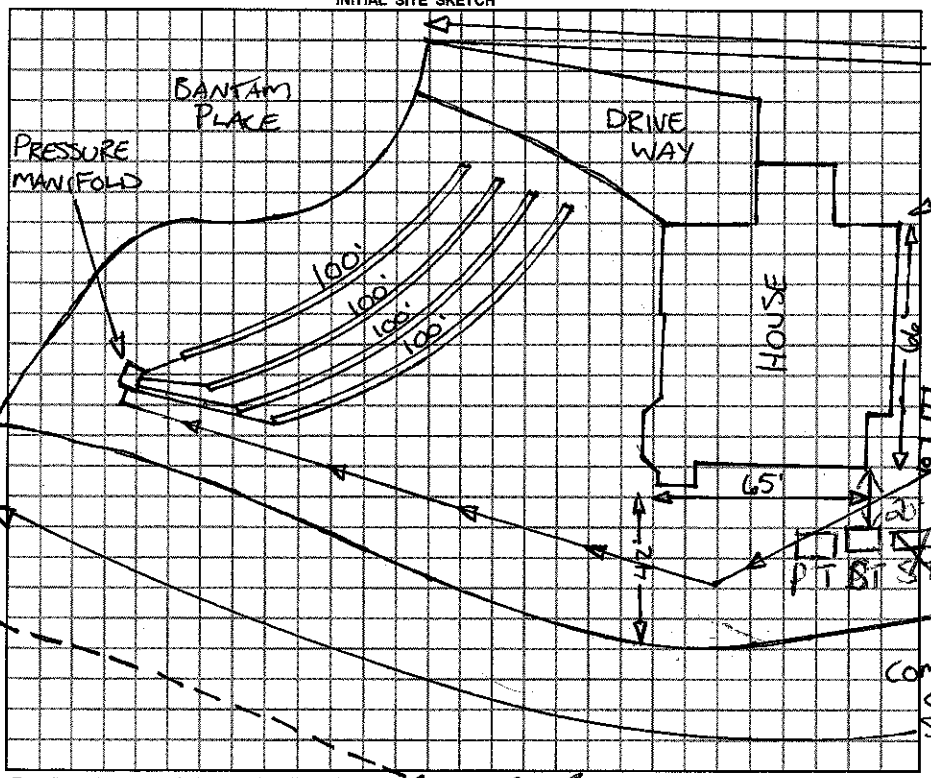

AS BUILT SKETCH

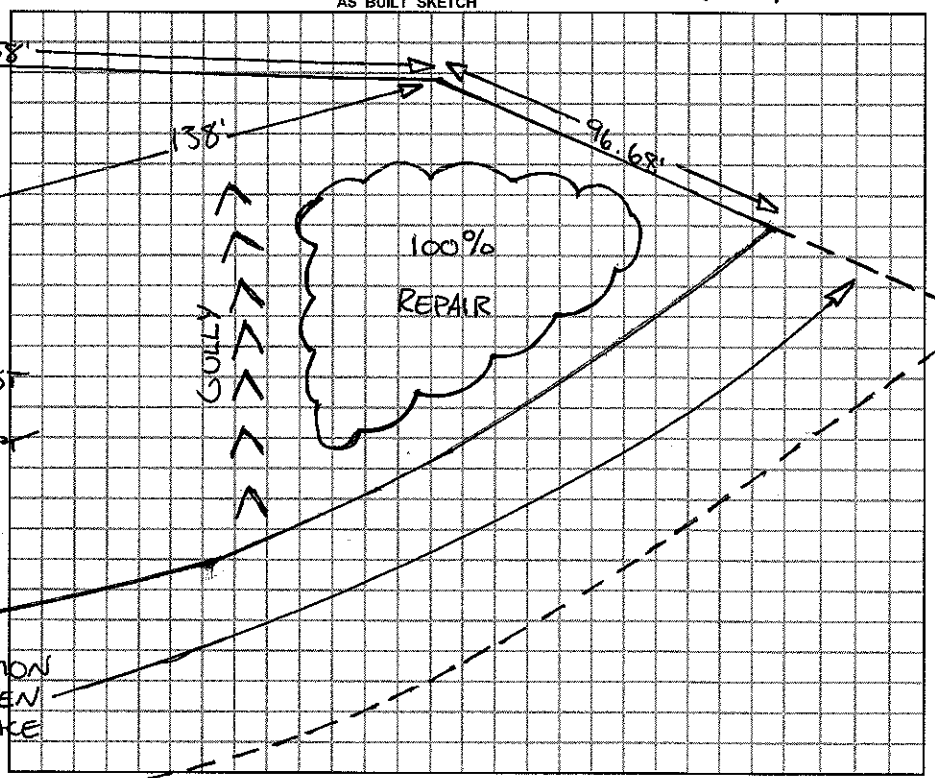

Permit can be suspended or revoked if any false information is supplied toward securing the permit / any unauthorized changes are made to the site / any unauthorized changes are made in the installation of the system.

☐ IMPROVEMENT PERMIT w / plat / not without expiration ☒ IMPROVEMENT PERMIT w / site plan valid for 60 mos. ☒ AUTHORIZATION TO CONSTRUCT valid for period equal to IMPROVEMENT PERMIT-not to exceed 60 mo.

Owner / Applicant Signature: Date 6-26-2009

Improvement Permit by: Date 6-25-09

Authorization to Construct by: Date 6-26-09

YOU SHOULD CONTACT A LOCATOR SERVICE PRIOR TO ANY EXCAVATION.

Installed by: Richard Abernathy

Operation Permit by: Date: 5/10/2010

Existing System Inspected by: Date:

WHITE COPY Environmental Health YELLOW COPY (Final) Owner / Applicant PINK COPY (Initial) Owner / Applicant