IREDELL COUNTY HEALTH DEPARTMENT

Statesville Office (704) 878-5305 Mooresville Office (704) 660-3625 PERMIT # 207849

IMPROVEMENT PERMIT / AUTHORIZATION TO CONSTRUCT / OPERATION PERMIT / EXISTING SYSTEM

PIN # 4626586246

APPLICANT: Lombardo Swimming Pools APPLICANT ADDRESS: 1501 Industrial Drive Matthews NC

SITE ADDRESS: 114 Bells Run Court Mooresville NC 28117 PHONE: (704) 847 4648 (704) 619 9187 ALT. PHONE: (704) 345 3711 Scott Rodeville (owner)


SITE DIRECTIONS: Go Brawley Sch Rd TR on McKendree Rd TR on Grasshopper TR on Cherry Tree Dr TL on Bells Run Court

SUBDIVISION: The Farm SECTION: 5 LOT # 583 LOT AREA: 1.53 ac DESIGN FLOW: 600 L.T.A.R.:


Septic Tank	existing 9'x11' (gal)	STB	Date	☐ New System ☐ Repair ☐ Expansion System Type: I II III IV V VI	☐ Residence	No. Bedrooms 5	Water Supply
Pump Tank	5x8' (gal)	PT	Date	System Description:	☐ Business	No. Persons	☐ Private
Pump Make		Model	Serial #	Repair System Description:	☐ Other	No. Employees	☐ Public
# Nitrification Fields	# Lines		Linear Ft:	Maintenance Agreement Required: ☐ YES ☐ NO	☐ Slab	☐ Crawl Space	☑ Community
Trench Width	Max. Trench Bottom Depth		Gravel Depth	☐ GRAVITY ☑ PRESSURE	☐ Basement w/plumbing		☐ Basement w/o plumbing

Comments / Conditions: Pool location as shown on site plan is too close to the pump tank. Septic tank and pump tank were located and flagged w/red flags and 15' minimum set back from the tanks was marked with white flags. Edge of pump tank is 22' from back wall of house. With 15' bldg setback to pool the minimum distance from pool to house is 37'. 40' is recommended. This authorization does not authorize any increase in daily waste flow, number of bedrooms or use of structure from original permit. Only authorizes a pool construction 15' from all parts of septic system and repair area. Recommend maintaining 5' from pool deck to both tanks also. Notified owner by phone of recommendation to avoid placing wood/concrete deck over tanks.

INITIAL SITE SKETCH

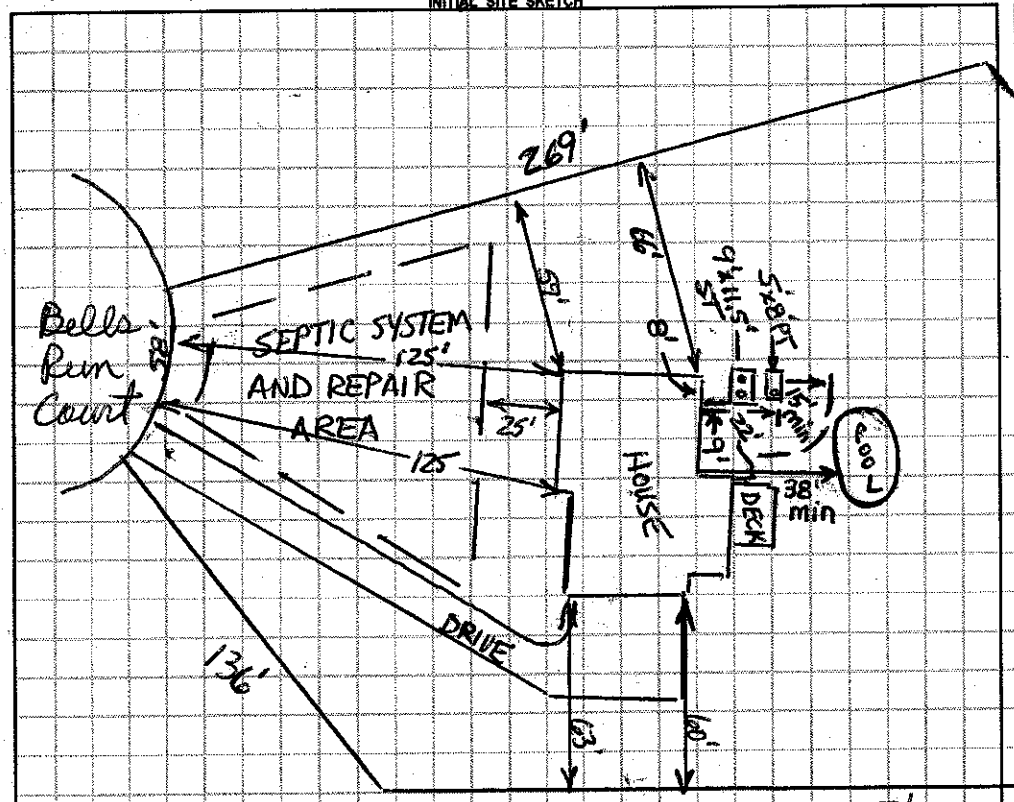

AS BUILT SKETCH

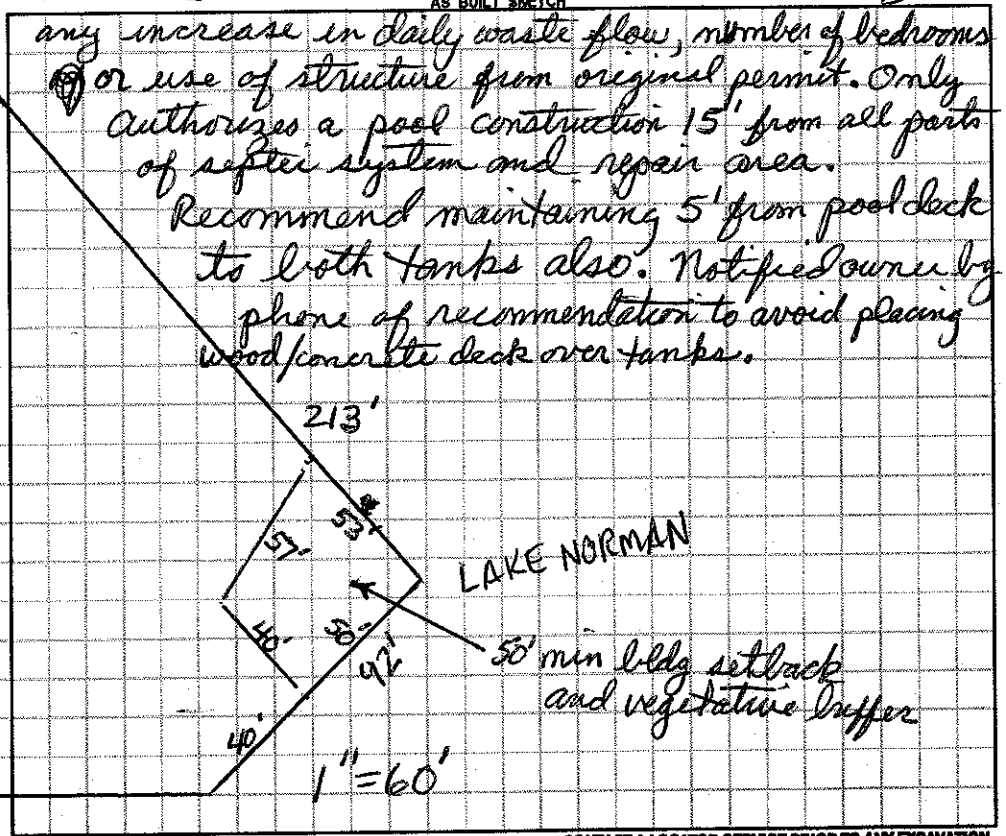

Permit can be suspended or revoked if any false information is supplied toward securing the permit / any unauthorized changes are made to the site / any unauthorized changes are made in the installation of the system. **CONTACT A LOCATOR SERVICE PRIOR TO ANY EXCAVATION**

☐ **IMPROVEMENT PERMIT** *with plat valid without expiration.* ☐ **IMPROVEMENT PERMIT** *with site plan valid for 60 mos.* ☐ **AUTHORIZATION TO CONSTRUCT** *valid for period equal to IMPROVEMENT PERMIT--not to exceed 60 mo.*

Owner / Applicant Signature: Keith Lundberg Date: 11 FEB 05 Installed by:

IMPROVEMENT PERMIT by: Date: OPERATION PERMIT by: Date:

AUTHORIZATION TO CONSTRUCT by: Date: Existing System Inspected by: Richard Farris Date: 1/27/15

Health Dept. Copy - WHITE Applicant (Final Approval) - YELLOW Applicant (Conditional Approval) - PINK