IREDELL COUNTY HEALTH DEPARTMENT - *ENVIRONMENTAL HEALTH* ☐ STATESVILLE OFFICE 704-878-5305 ☒ MOORESVILLE OFFICE 704-664-5281

IMPROVEMENT PERMIT / AUTHORIZATION TO CONSTRUCT / OPERATION PERMIT / EXISTING SYSTEM INSPECTION

PERMIT # 139336 PIN # 4626-58-7031 DATE 4-10-12

OWNER M I Homes APPLICANT: SAME PHONE: Home/Cell # 704-402-7882 Business #

SITE ADDRESS STAMFORD CT OWNER / APPLICANT ADDRESS 9335 HARRIS CORNERS PKWY

SITE DIRECTIONS BSR, McKENDREE, GRASSHOPPER, CHERRY TREE, STAMFORD

SUBDIVISION THE FARMS BLOCK / SECTION 5 LOT # 579 LOT AREA .721 AC DESIGN FLOW 600 GPD L.T.A.R. .3

Septic Tank 1500 Gallons: STB 338 Date 8-4-12

Pump Tank 1500 Gallons: PT 477 Date 7-28-12

Pump Make MYERS Model ME50 Serial # ½HP

No. Nitrification Fields: 1 No. Lines 6 Linear Feet 334'

Trench Width 24-36" Max. Trench Bottom Depth 36" Gravel Depth —

☒ New System ☐ Repair ☐ Expansion System Type I II III (IV) V VI

System Description: LP- PANEL BLOCK

Repair System Description: SAME

Maintenance Agreement Required ☒ YES ☐ NO

☐ GRAVITY ☒ PRESSURE


☒ Residence No. Bedrooms 5 ☐ Business No. Persons ☐ Other No. Employees ☐ Slab ☒ Crawl Space ☐ Basement w/plumbing ☐ Basement w/o plumbing

Water Supply: ☐ Private ☐ Public ☒ Community

Comments / Conditions


RASHREE@SAVANTGP.com

INITIAL SITE SKETCH

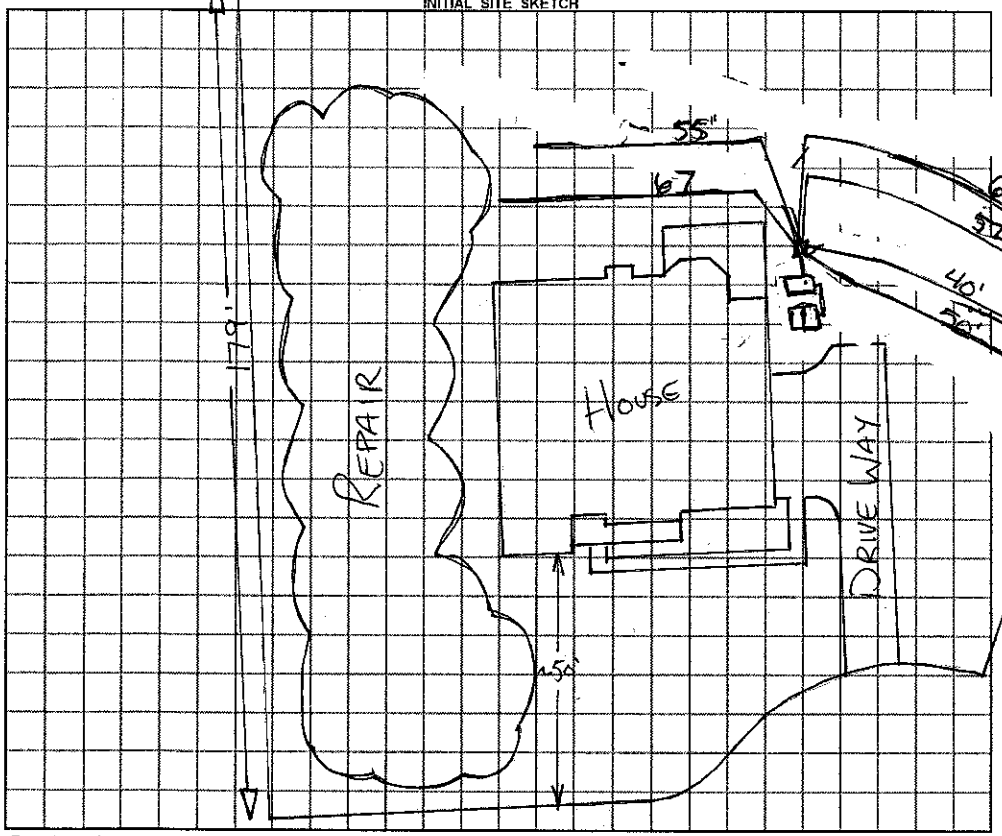

AS BUILT SKETCH

1"=40'

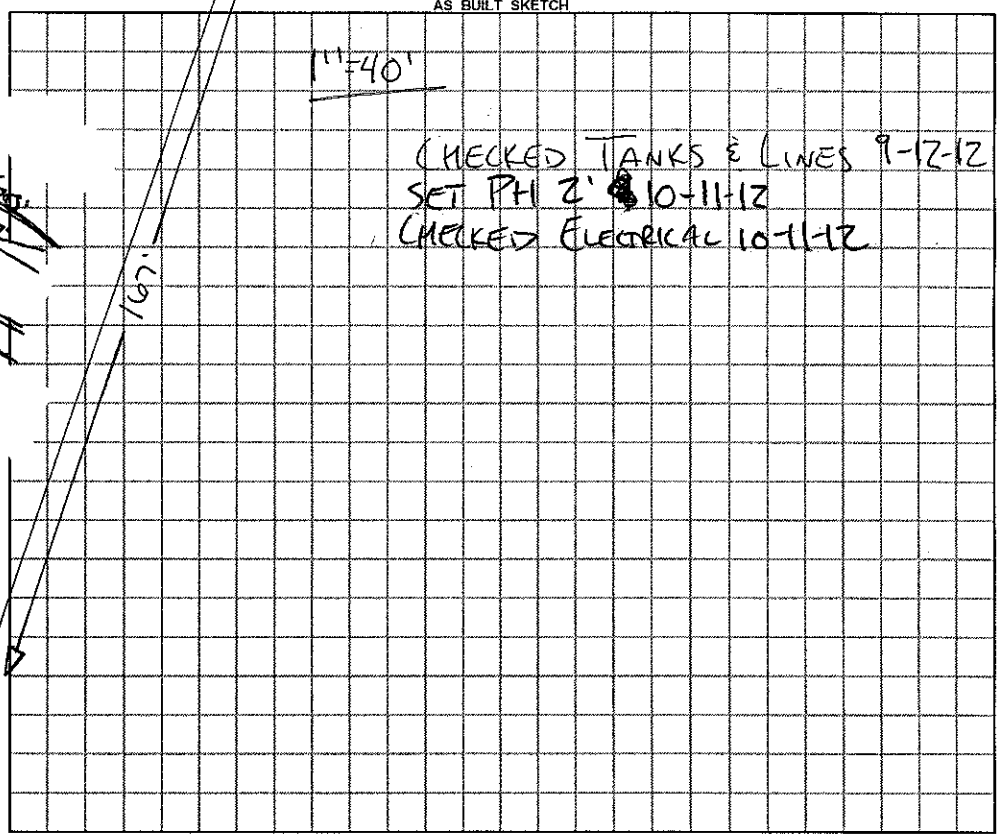

CHECKED TANKS & LINES 9-12-12
SET PH 2' 10-11-12
CHECKED ELECTRICAL 10-11-12

Permit can be suspended or revoked if any false information is supplied toward securing the permit / any unauthorized changes are made to the site / any unauthorized changes are made in the installation of the system.

☐ ***IMPROVEMENT PERMIT*** *with plat valid without expiration.* ☐ ***IMPROVEMENT PERMIT*** *with plat valid without expiration.* ***site plan valid 60 mo.*** ☒ ***AUTHORIZATION TO CONSTRUCT*** valid for period equal to IMPROVEMENT PERMIT--not to exceed 60 mo.

Owner / Applicant Signature: Nancy King Date 4-17-12 Installed by: ARBORMATHY

IMPROVEMENT PERMIT by: REHS Date 4-10-12 OPERATION PERMIT by: REHS REHS Date 10-11-12

AUTHORIZATION TO CONSTRUCT by: REHS Date 4-10-12 Existing System Inspected by: REHS Date

YOU SHOULD CONTACT A LOCATOR SERVICE PRIOR TO ANY EXCAVATION

White Copy – Environmental Health YELLOW COPY (Final) Owner / Applicant PINK COPY (Initial) Owner / Applicant