IREDELL COUNTY HEALTH DEPARTMENT

Stage Builders

STATESVILLE 704-878-5305 MOORESVILLE 704-664-5281

IMPROVEMENT PERMIT / CERTIFICATE OF COMPLETION / OPERATION PERMIT / EXISTING SYSTEM INSPECTION

PROPERTY DESCRIPTION NO. 21956 DATE 9/18/95 TAX MAP NO. 2E 2A 474 4626 589650 Watershed: [X] Yes [ ] No

OWNER OR CONTRACTOR Crescent Res. Inc. (MIKE CLARK) PHONE: Business 528-3999. Home

ADDRESS PO Box 1003 Chas. NC. 28201

LOCATION Grasshopper (R) from McKendree on (R) just before Dan East Rd.

SUBDIVISION CL+T BLOCK / SECTION 8 LOT 1574 LOT AREA .9 AC SITE CLASS. P DESIGN FLOW 480 L.T.A.R. .35

Septic Tank: 1000 Gallons; STB 825 Date 3/26/96

Pump Tank: 1000 Gallons; PT 49 Date

Pump Make: ZOELLER Model N-137C Serial No. 137-0002

Nitrification Field: No Fields 1 Square Feet 1028 Linear Feet * 257

No Lines 2 Trench Width 36" Max Trench Bottom Depth 36" Gravel Depth N/A

[X] New System [ ] Repair System Type: I, II, III, IV, V, VI

System Description: Pres. Manifold - Infiltrator

Repair System Description: None

Maintenance Agreement Required: [X] Yes [ ] No

[X] House/Mod. Home No. Bedrooms 3

[ ] Mobile Home No. Bathrooms 2

[ ] Business No. Employees

[ ] Other


[ ] Slab [ ] Crawl Space [X] Basement w/plumbing [ ] Basement wo/plumbing

Water Supply: [X] Individual [ ] Community [ ] Public

Comments:

Comments:
Doors on Tanks
5" drawdown / dose = 100 GAL / DOS
FLOAT TREE - RAISE ALARM

INITIAL SITE SKETCH

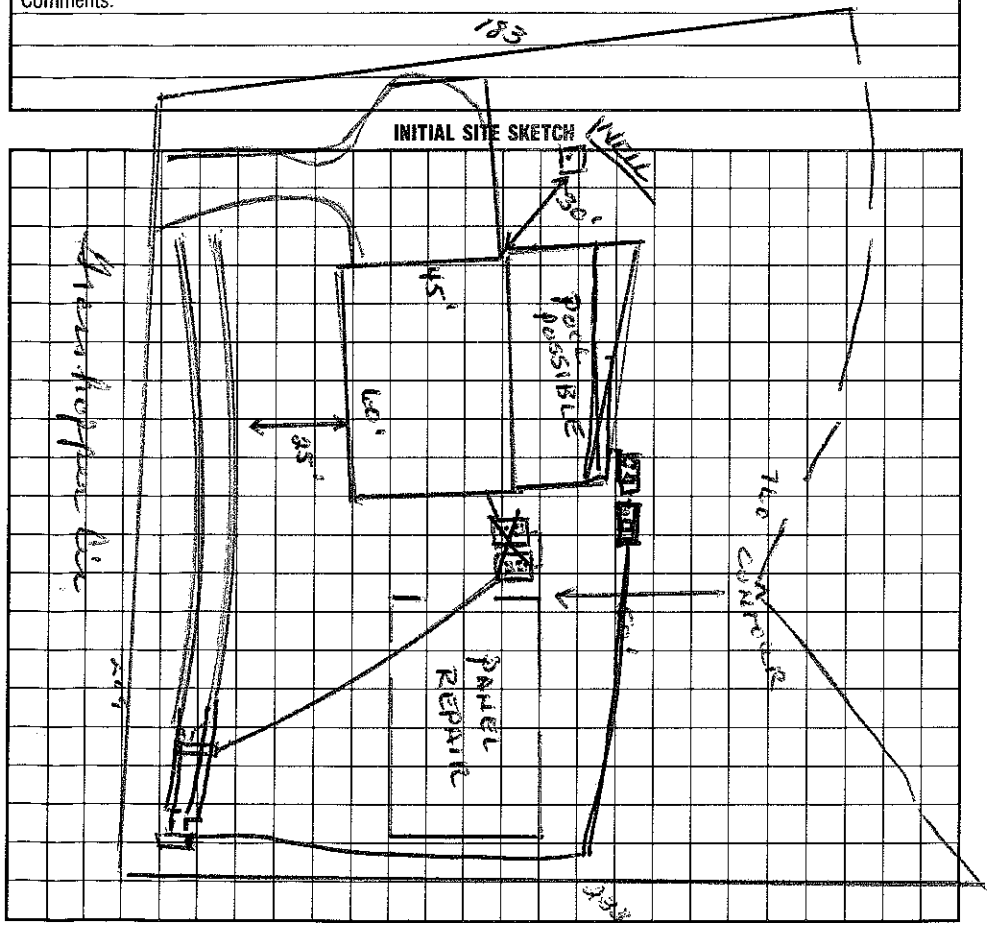

AS BUILT SKETCH

Electrical Pending 8/14/96

I understand that this permit can be suspended or revoked if any false information is supplied toward securing the permit/any unauthorized changes are made to the site/any unauthorized changes are made in the installation of the system.

Signed: Paul B. Penny

Improvement Permit by: Wesley Sparks R.S. date 9/18/95

Existing System Inspection by: date

Installed by: Curt Dunning

Certificate of Completion by: date

Operation Permit by: Wesley Sparks R.S. date 8/14/96

HEALTH DEPT. COPY: WHITE INSPECTION COPY (FINAL): GREEN OWNER COPY (FINAL): YELLOW INSPECTION COPY (INITIAL): PINK OWNER COPY (INITIAL): GOLD