IREDELL COUNTY HEALTH DEPARTMENT

Statesville Office (704) 878-5305 Mooresville Office (704) 660-3625 PERMIT # 139654

IMPROVEMENT PERMIT / AUTHORIZATION TO CONSTRUCT / OPERATION PERMIT / EXISTING SYSTEM

PIN # 4626-59-0440

APPLICANT: LARRY THOMPSON / True Homes APPLICANT ADDRESS: 175 KLUTTZ RD. SALISBURY

SITE ADDRESS: 126 MONTCLAIRE DR. PHONE: 704-301-4883 ALT. PHONE:

SITE DIRECTIONS: BSR, TR MCKENDREE, TR DIGH, TR MONTCLAIRE, ON R

SUBDIVISION: THE FARMS SECTION: 5 LOT # 560 LOT AREA: .79AC DESIGN FLOW: 480 L.T.A.R.: .25

Septic Tank 1500 1530 (gal) STB 3000 - 1567 Date infiltrator

Pump Tank 1500 (gal) PT 1530P Date

Pump Make Zoeller Model E189F Serial # 189-0094

Nitrification Fields 1 # Lines 4C 120' Linear Ft: 480'

Trench Width 36" Max. Trench Bottom Depth 36" Gravel Depth —

☒ New System ☐ Repair ☐ Expansion System Type: I II (III)B IV V VI

System Description: PM - 25% REDUCTION

Repair System Description: LP PPBPS

Maintenance Agreement Required: ☐ YES ☒ NO ☐ GRAVITY ☒ PRESSURE

☒ Residence ☐ Business ☐ Other ☐ Slab ☐ Basement w/plumbing ☐ Crawl Space ☐ Basement w/o plumbing

No. Bedrooms 4 No. Persons — No. Employees —

Water Supply: ☐ Private ☐ Public ☒ Community

240

Comments / Conditions: ★ Septic, Drainfield, located offsite
★ Supply line re-routed to side of drive
5/12/15 Set 2ft pressure, Checked & Elect & alarm.

4/1/14 Reviewed Floor plans, House is Slightly larger than original foot print but Should Still fit fine to drainfield located offsite.
★★ Septic tanks & pumptank must be at least 50ft from lake

INITIAL SITE SKETCH

Overby installed tanks & lines
Sid Gaskins Finished

SEE APPROVED PLAN FROM

LARRY THOMPSON

AS BUILT SKETCH

Pump line Manifold

inspected drainlines 12/9, 10/14 RT
tanks 12/11/14

— drill needs pump/alarm insp
— electric panel
— pressure head

Permit can be suspended or revoked if any false information is supplied toward securing the permit / any unauthorized changes are made to the site / any unauthorized changes are made in the installation of the system. **CONTACT A LOCATOR SERVICE PRIOR TO ANY EXCAVATION**


☐ **IMPROVEMENT PERMIT** *with plat valid without expiration.* ☒ **IMPROVEMENT PERMIT** *with site plan valid for 60 mos.* ☐ **AUTHORIZATION TO CONSTRUCT** *valid for period equal to IMPROVEMENT PERMIT--not to exceed 60 mo.*

Applicant Signature: X [signature] Date: 4-2-14 Installed by: Overby Septic / Sid Gaskins

PERMIT by: [signature] APPROVED MAR 25 2014 OPERATION PERMIT by: [signature] RS Date: 5/12/15

CONSTRUCT by: [signature] RS Date: 4/1/14 Existing System Inspected by: Date:

Health Dept. Copy - WHITE Applicant (Final Approval) - YELLOW Applicant (Conditional Approval) - PINK

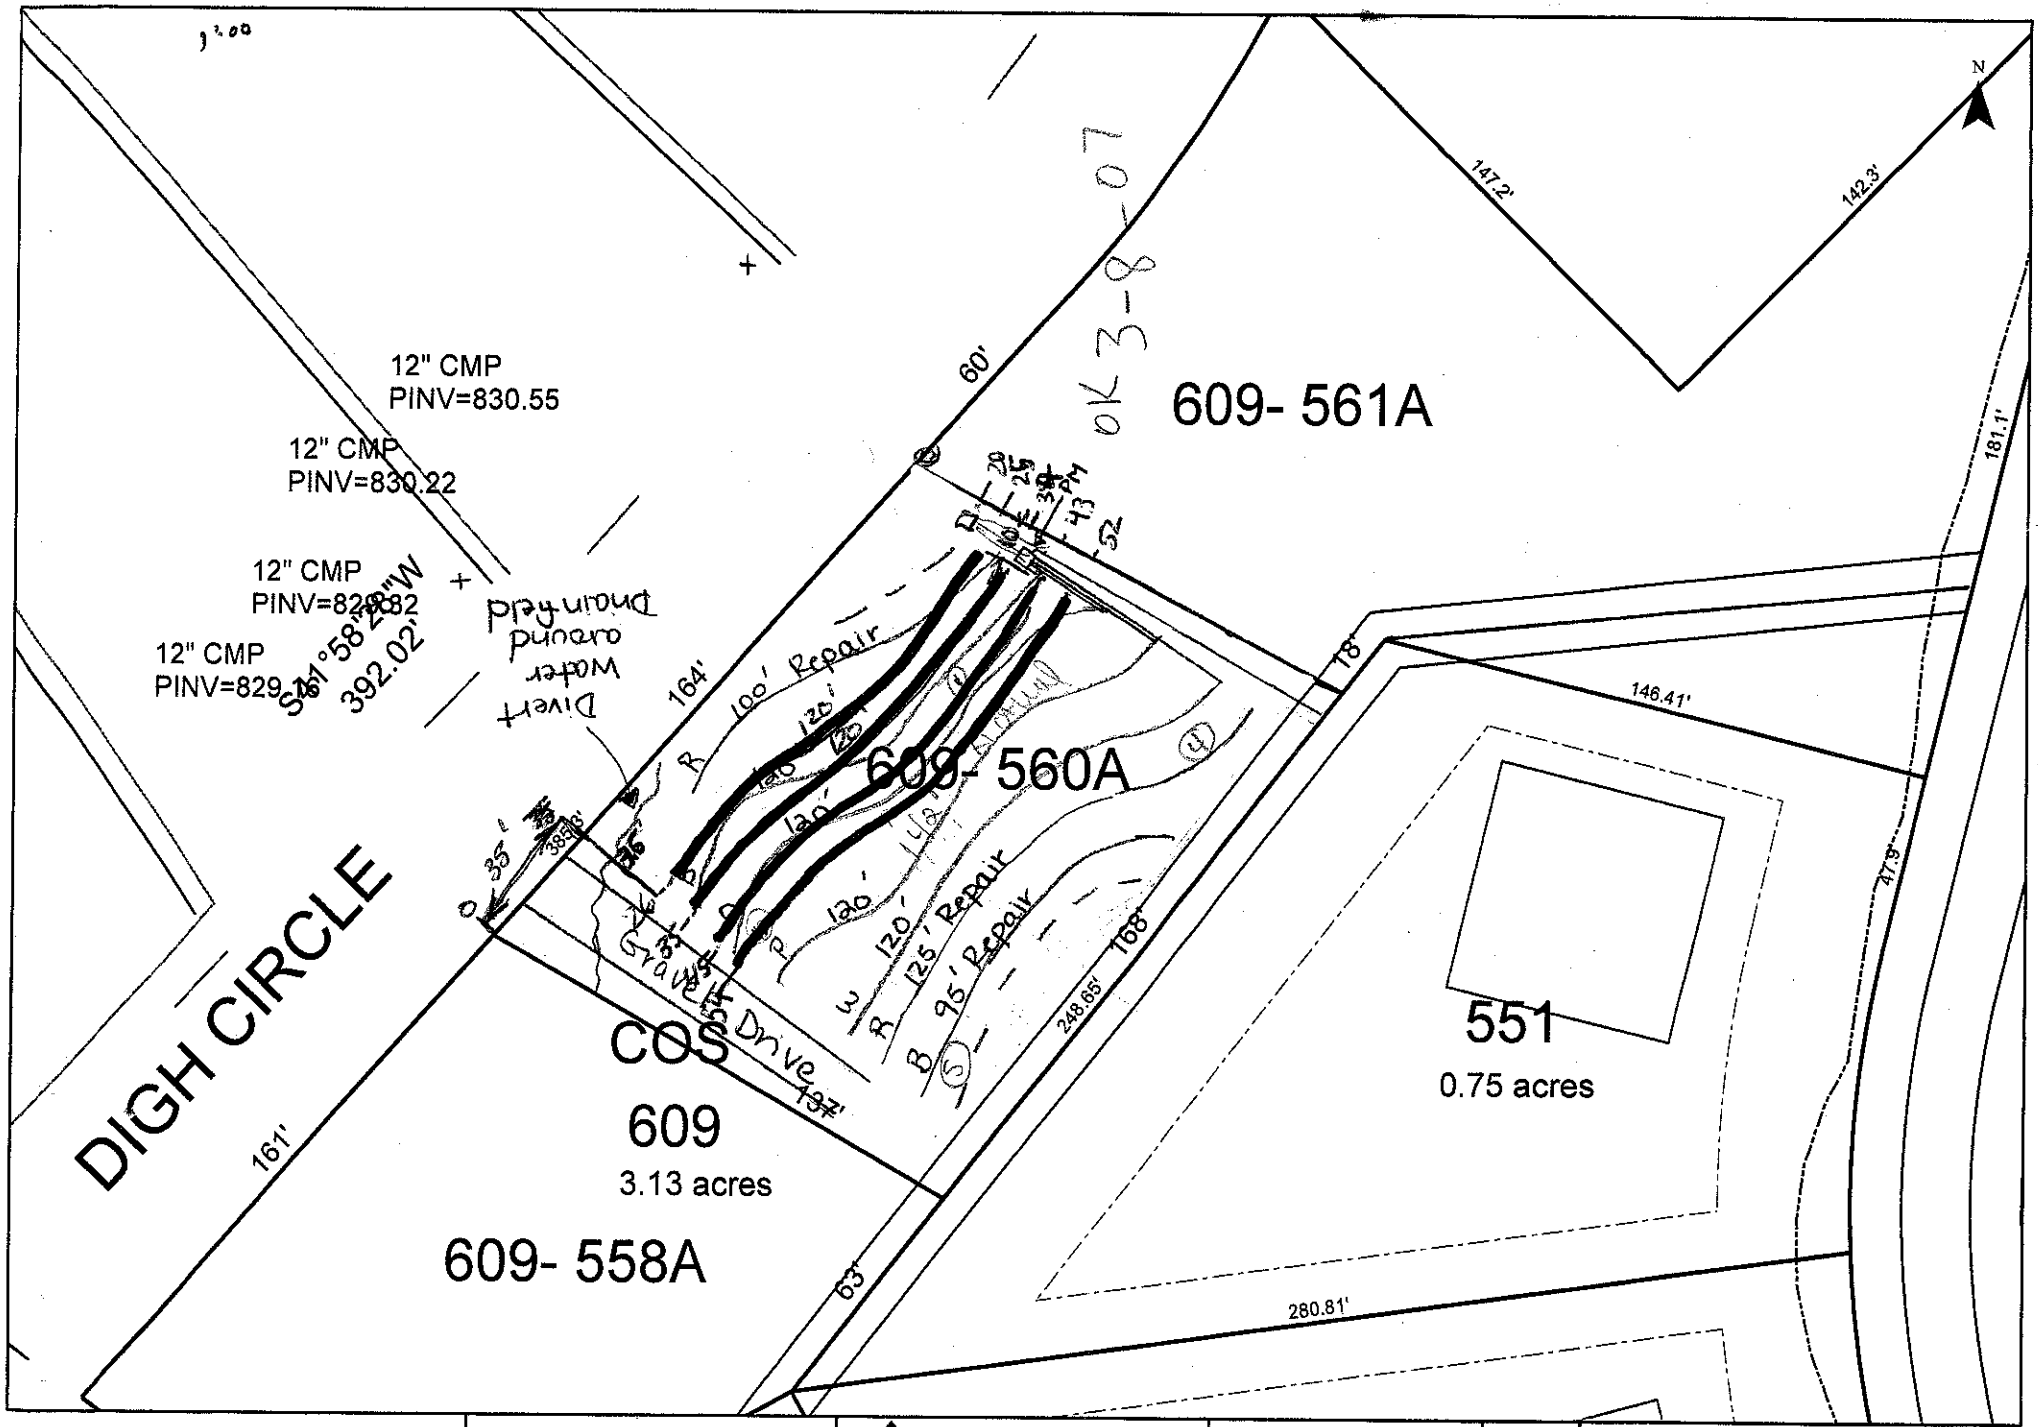

Scale: 1 inch equals 50 feet	S&ME	The Farms - Phase V	FIGURE
Drawn by: JBP		Lot 560	2
Reviewed by: KS		Iredell County, NC	
Date: February, 2007	ENVIRONMENTAL SERVICES · ENGINEERING · TESTING	S&ME Project #1588-05-070	