IREDELL COUNTY HEALTH DEPARTMENT

STATESVILLE 704-878-5305 MOORESVILLE 704-664-5281

IMPROVEMENT PERMIT / AUTHORIZATION TO CONSTRUCT / OPERATION PERMIT / EXISTING SYSTEM INSPECTION

PERMIT# 83427 PIN# 4626 592 797 DATE 6/22/01

OWNER OR CONTRACTOR Locke C. Long Jr. PHONE: Business Home

ADDRESS 423 Bubbling Well Rd Matthews NC 28105

LOCATION Brawley school, TR McKendree, TR Dogh Cir, TR Mont clair on RT

SUBDIVISION CL+T BLOCK / SECTION 8 LOT 406 LOT AREA .554c SITE CLASS. PS DESIGN FLOW 360 L.T.A.R. 0.3

Septic Tank: 1600 Gallons; STB 97 Date 3/20/01

Pump Tank: 1000 Gallons; PT 71 Date 6/26/01

Pump Make: Meyers Model ME50 Serial No.

Nitrification Field: No Fields 1 Square Feet 1200 Linear Feet 400

No Lines 5 @ 80' Trench Width 36" Max Trench Bottom Depth 36" Gravel Depth 12"

☒ New System ☐ Repair System Type: I, II, III, IV, V, VI

System Description: Pressure Man. Conventional

Repair System Description: Pump Panel

Maintenance Agreement Required: ☐ Yes ☒ No

☒ House/Mod. Home No. Bedrooms 3

☐ Mobile Home No. Bathrooms 3

☐ Business No. Employees

☐ Other


☐ Slab ☐ Crawl Space ☒ Basement w/plumbing ☐ Basement wo/plumbing

Water Supply: ☒ Individual ☐ Public ☐ Community


Comments:/Conditions:

Comments:/Conditions:

INITIAL SITE SKETCH

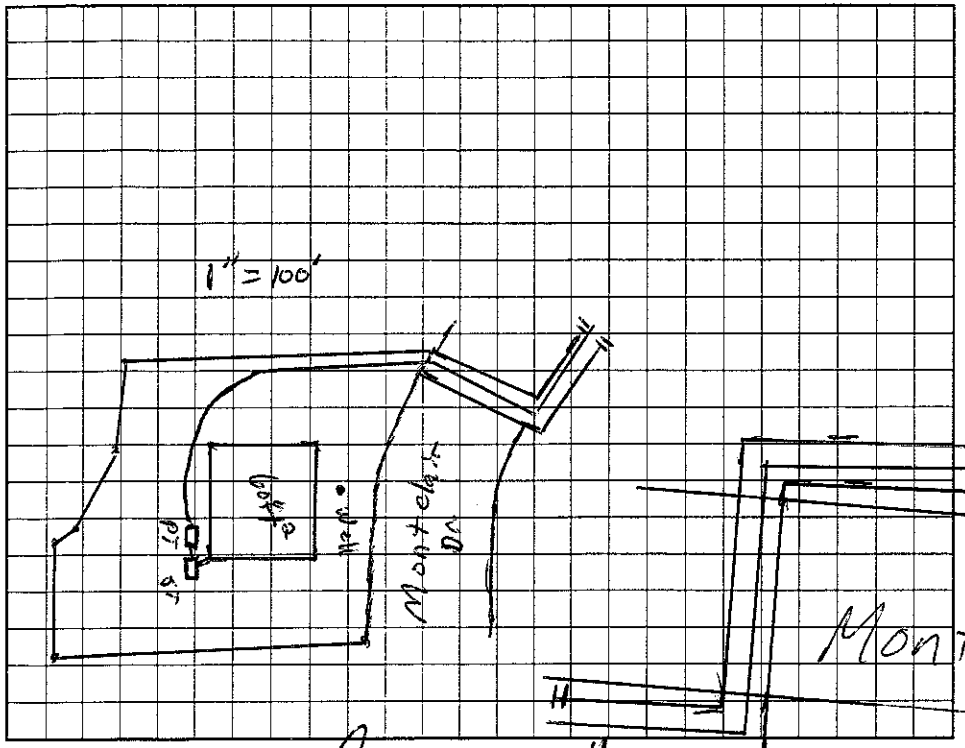

AS BUILT SKETCH

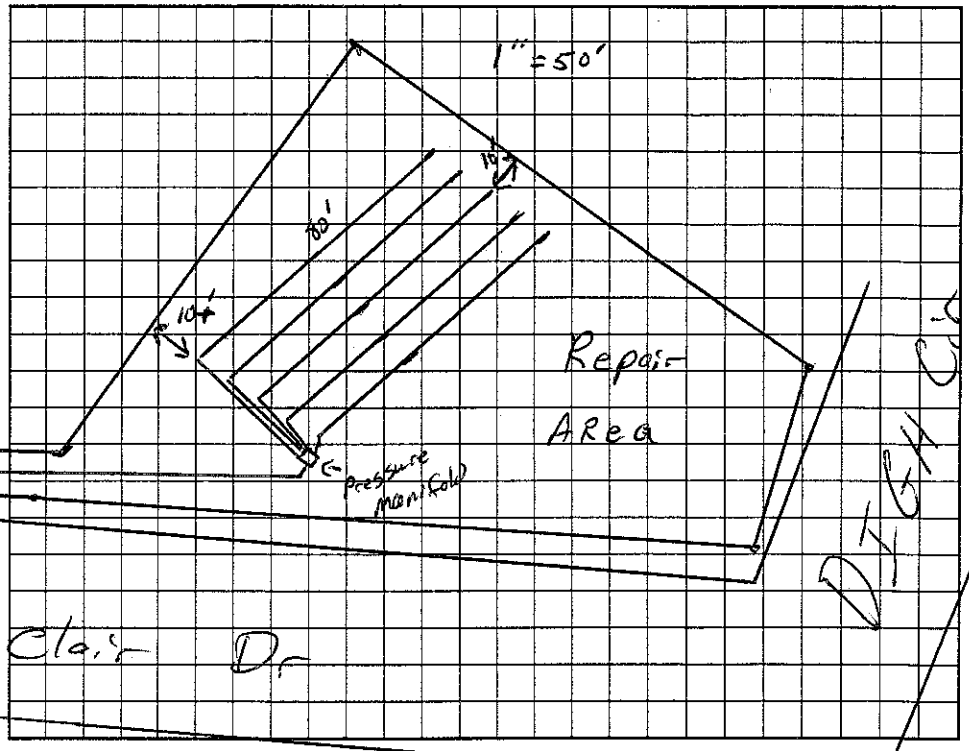

Permit can be suspended or revoked if any false information is supplied toward securing the permit/any unauthorized changes are made to the site/any unauthorized changes are made in the installation of the system. Improvement Permit with plat valid without expiration. Improvement Permit with site plan valid for sixty months. Authorization to Construct is valid for a period equal to that of Improvement Permit – not to exceed sixty months.

Signed: date

Improvement Permit by: RSI date 6/22/01

Authorization to Construct by: RSI date 6/22/01

Installed by: WT Norwood

Operation Permit by: RSI date 10/26/01

Existing System Inspection by: date

HEALTH DEPT. COPY: WHITE OWNER COPY (FINAL): YELLOW OWNER COPY (INITIAL): PINK