IREDELL COUNTY HEALTH DEPARTMENT

Statesville Phone TR 3-7271 — Mooresville Phone NO 3-1271

PERMIT TO INSTALL SEPTIC TANK

Permit No. 80 — Permit Date _____ 19__

Owner ? A.C. Martin — Address _____

Installed By E.J. Ervin — Address Mooresville


Location of Property Hwy 150 to Johns Trading Post. Turn right on road 1115. Go 3rd road to right. Loop right 1st house. Sept. 8 Lot 403

Tank		Capacity		Length of Lines		Fixtures	
Block	( )	1000	( )	225'	( )	No. of Baths	(1)
Precast	(✓)	1250	( )	250'	( )	Dishwasher	( )
		1500	( )	Other 120'		Garbage Grdr.	( )
		Other _____		300 ft.		Other _____	

NOTIFY HEALTH DEPARTMENT AT LEAST EIGHT HOURS BEFORE TANK IS TO BE INSPECTED.

Final Inspection 7-2-19L — Approved (✓) Disapproved ( )

Remarks Layed out by Glenn Fox. Problem site. Too wet deep for stone trench up for not enough room.

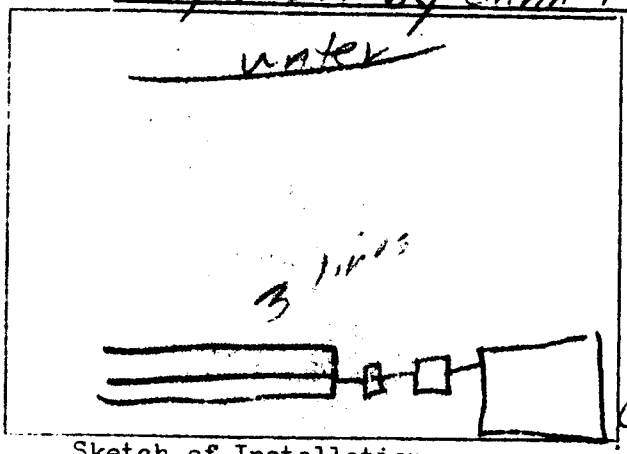

Sketch of Installation

Sanitarian