IREDELL COUNTY HEALTH DEPARTMENT

STATESVILLE 704-878-5305 MOORESVILLE 704-664-5281

IMPROVEMENT PERMIT / AUTHORIZATION TO CONSTRUCT / OPERATION PERMIT / EXISTING SYSTEM INSPECTION

PERMIT # 155747 PIN # 4626-59-6208 DATE 4-3-09

OWNER or APPLICANT ROBERT + HARRIETT FLOYD PHONE: Business 980-721-6778 Home:

OWNER or APPLICANT ADDRESS 181 GRASSHOPPER CR. MOORESVILLE NC 28117

LOCATION / DIRECTIONS BSR, TR MCKENDREE, TR GRASSHOPPER

SUBDIVISION CL+T BLOCK / SECTION 8 LOT # 420 B LOT AREA DESIGN FLOW 360 L.T.A.R.

Septic Tank Gallons: STB Date

Pump Tank EXISTING Gallons: PT Date

Pump Make Model Serial #

Nitrification Field No Fields No Lines Linear Feet

Trench Width Max. Trench Bottom Depth Gravel Depth

☐ New System ☐ Repair ☐ Expansion System Type I II III IV V VI

System Description: EXISTING BED

Repair System Description:

Maintenance Agreement Required ☐ YES ☐ NO

☐ GRAVITY ☐ PRESSURE

☒ Residence No. Bedrooms 3

☐ Business No. Persons

☐ Other No. Employees

☐ Slab ☐ Crawl Space


☐ Basement w/plumbing ☐ Basement w/o plumbing

Water Supply: ☒ Private ☐ Public ☐ Community


Comments / Conditions SYSTEM GOOD FOR 3 BED ROOMS

Comments / Conditions

INITIAL SITE SKETCH

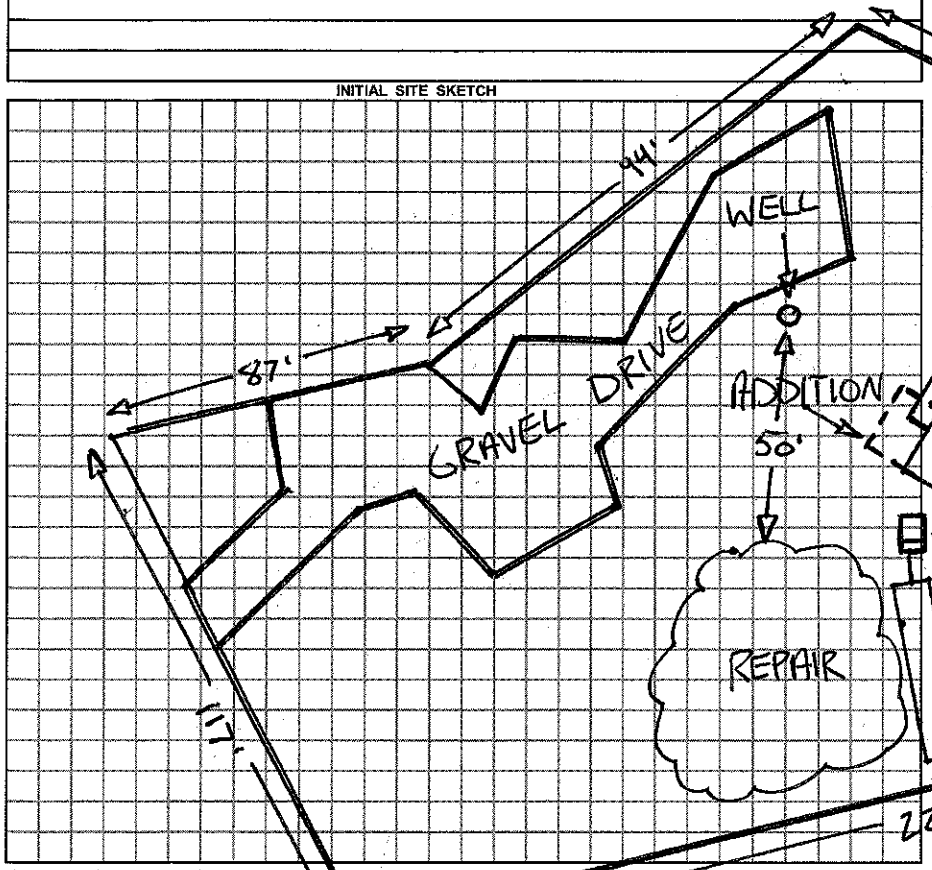

AS BUILT SKETCH

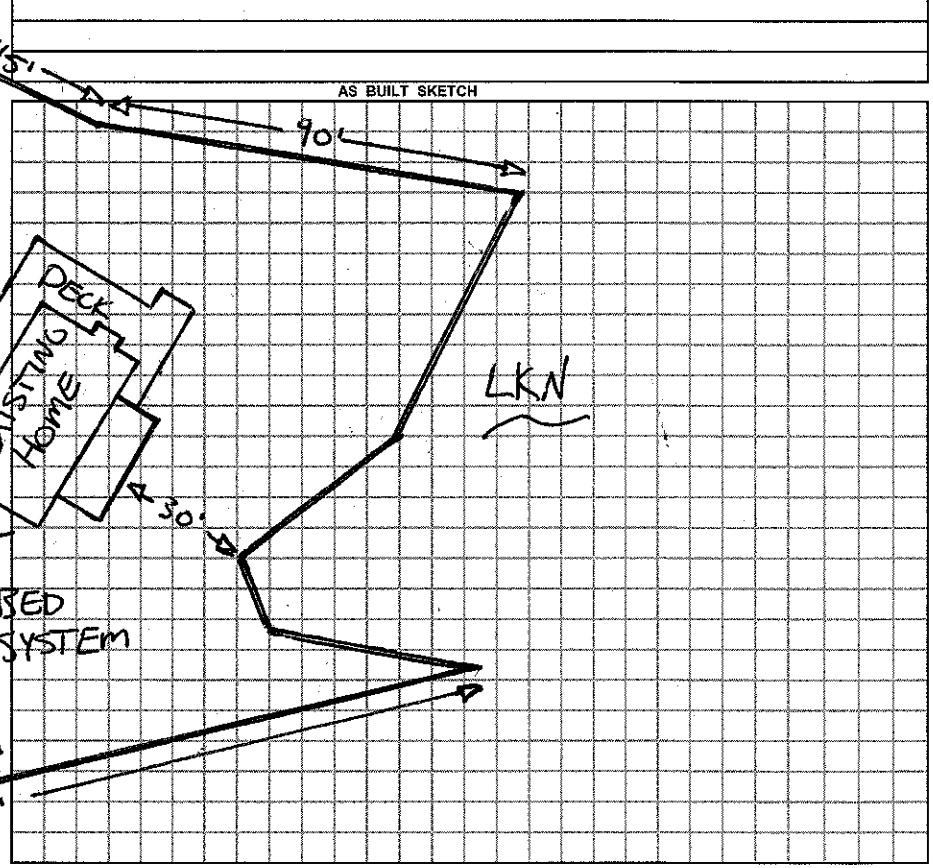

Permit can be suspended or revoked if any false information is supplied toward securing the permit / any unauthorized changes are made to the site / any unauthorized changes are made in the installation of the system.

☐ *IMPROVEMENT PERMIT w / plat valid without expiration* ☐ *IMPROVEMENT PERMIT w / site plan valid for 60 mos.* ☒ *AUTHORIZATION TO CONSTRUCT valid for period equal to IMPROVEMENT PERMIT-not to exceed 60 mo.*

Owner / Applicant Signature: Date 4/16/09

Improvement Permit by: Date

Authorzation to Construct by: Date

Installed by:

Operation Permit by: Date: 4-3-09

Existing System Inspected by: Date:

YOU SHOULD CONTACT A LOCATOR SERVICE PRIOR TO ANY EXCAVATION.

WHITE COPY Environmental Health YELLOW COPY (Final) Owner / Applicant PINK COPY (Initial) Owner / Applicant