1:30

IREDELL COUNTY HEALTH DEPARTMENT

STATESVILLE 704-878-5305 MOORESVILLE 704-664-5281

IMPROVEMENT PERMIT / AUTHORIZATION TO CONSTRUCT / OPERATION PERMIT / EXISTING SYSTEM INSPECTION

PERMIT# 139355 PIN# 4626581913.593 4626598147 DATE 12-2-09

OWNER OR APPLICANT Craig Carter Builders PHONE: Business 336 940-2341 Home

ADDRESS 157 Yadkin Valley Rd

LOCATION Brawley School Rd TR ~~Blume~~ Mc Kendree TR Grasshopper on right #176

SUBDIVISION The Farms BLOCK / SECTION 5 LOT 593 LOT AREA .89 Acre SITE CLASS. PS DESIGN FLOW 480 L.T.A.R. .3

Septic Tank ★1500✓ Gallons; STB 338-500 Date 2-18-11

Pump Tank: Gallons; PT Date

Pump Make: Model Serial No.

Nitrification Field: No Fields 1 Square Feet 1200 Linear Feet 400

No Lines 3 Trench Width 36" Max Trench Bottom Depth 36" Gravel Depth N/A

☒ New System ☐ Repair ☐ Expansion System Type: I II III IV V VI

System Description: Gravity – 25% Reduction

Repair System Description: 25%-50% Reduction

Maintenance Agreement Required: ☐ Yes ☒ No

☒ House/Mod. Home ☐ Mobile Home ☐ Business ☐ Other

No. Bedrooms 4 No. Persons No. Employees

Water Supply: ☐ Individual ☒ Public ☒ Community

☐ Gravity ☑ Pressure ☐ Slab ☒ Crawl Space ☐ Basement w/plumbing ☐ Basement wo/plumbing

Comments/Conditions: ★ Per Crescent Community specs


Comments/Conditions:

02-18-11 LINES & TANK CHECKED - CJH


02-18-11 Pool Area Very Limited - CJH

1:50

INITIAL SITE SKETCH

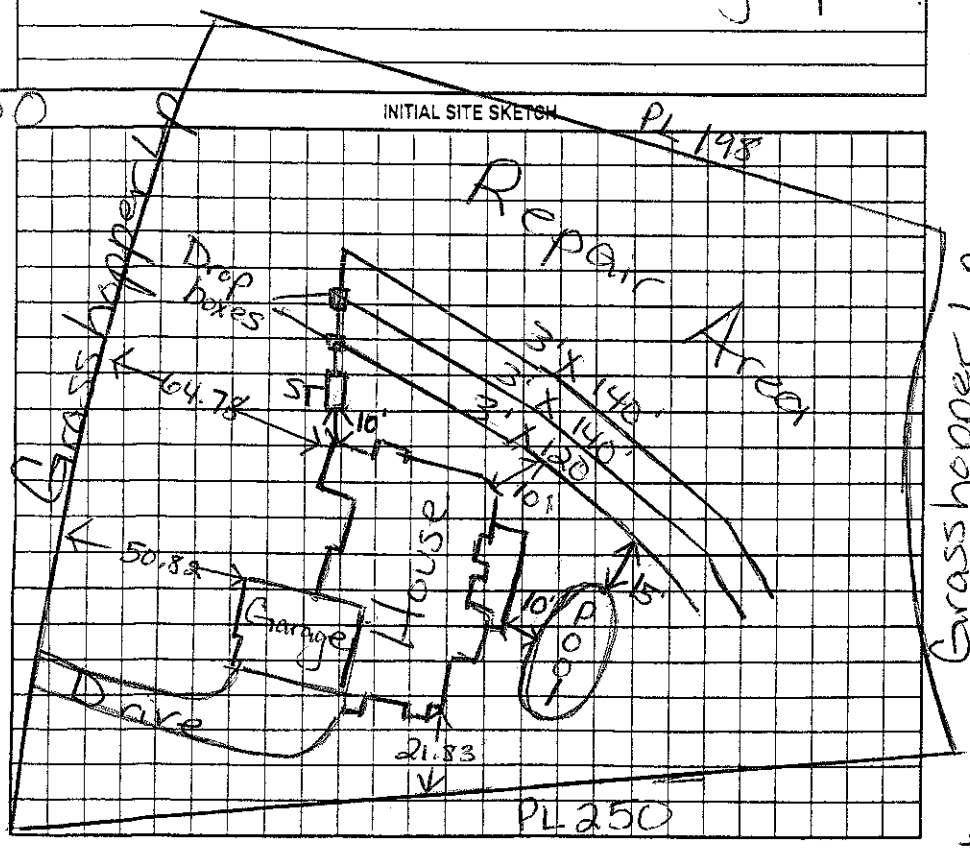

AS BUILT SKETCH

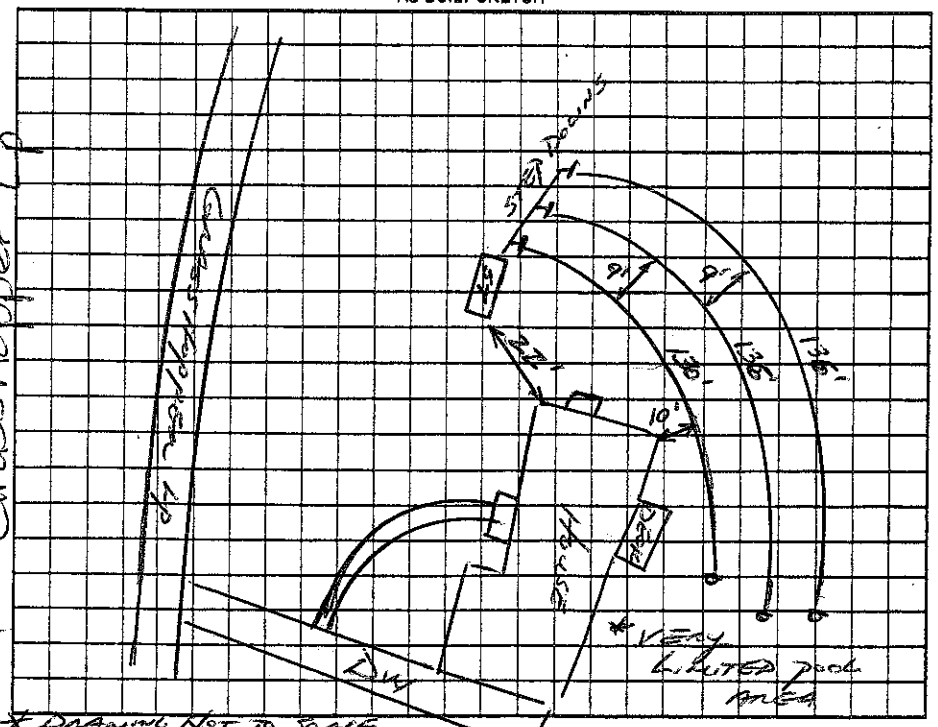

★ DRAWING NOT TO SCALE

Permit can be suspended or revoked if any false information is supplied toward securing the permit/any unauthorized changes are made to the site/any unauthorized changes are made in the installation of the system. Improvement Permit with plat valid without expiration ☐ Improvement Permit with site plan valid for sixty months ☐ Authorization to Construct is valid for a period equal to that of Improvement Permit – not to exceed sixty months.

Signed: Craig A. Carter date 12-2-09 Installed by: Abernathy Grading & Septic

Improvement Permit by: Marina Thibeault RS date 12/2/09 Operation Permit by: [signature] RS date 02-18-2011

Authorization to Construct by: Marina Thibeault RS date 12/2/09 Existing System Inspection by: date

HEALTH DEPT. COPY: WHITE OWNER COPY (FINAL): YELLOW OWNER COPY (INITIAL): PINK