IREDELL COUNTY HEALTH DEPARTMENT

Authorization to Construct

STATESVILLE 704-878-5305 MOORESVILLE 704-664-5281

IMPROVEMENT PERMIT / CERTIFICATE OF COMPLETION / OPERATION PERMIT / EXISTING SYSTEM INSPECTION

PROPERTY DESCRIPTION NO. 24157 DATE 6/26/96 TAX MAP NO. 2F 12 A 12 Watershed: ☒ Yes ☐ No

OWNER OR CONTRACTOR John Wieland Homes PHONE: Business 663-6905 ~~Home~~ 4626-60-1197

ADDRESS 8325 Arlan Ridge Blvd Char. NC. 28237

LOCATION Byow Sch TR Bay Harbour TL Lake Mist TL Jonquil Ct. (L) corner lot

SUBDIVISION Harbour BLOCK / SECTION 1 LOT 1 LOT AREA 1.65Ac SITE CLASS. PS DESIGN FLOW 480 L.T.A.R. .3

Septic Tank: 1000 Gallons; STB 794 Date 10/31/96

Pump Tank: _____ Gallons; PT _____ Date _____

Pump Make: _____ Model _____ Serial No. _____

Nitrification Field: No Fields 1 Square Feet 1600 Linear Feet 399*

No Lines 5 Trench Width 36" Max Trench Bottom Depth 36" Gravel Depth 6" SAND

☐ New System ☐ Repair System Type: I, II, (III) IV, V, VI

System Description: * Ch PLASTIC

Repair System Description: 16" Prefab Panel

Maintenance Agreement Required: ☐ Yes ☒ No

☒ House/Mod. Home ☐ Mobile Home ☐ Business ☐ Other

No. Bedrooms 4 No. Bathrooms 4 No. Employees ____


☐ Slab ☒ Crawl Space ☐ Basement w/plumbing ☐ Basement wo/plumbing

Water Supply: ☐ Individual ☒ Community ☐ Public


Comments:

Comments:

INITIAL SITE SKETCH

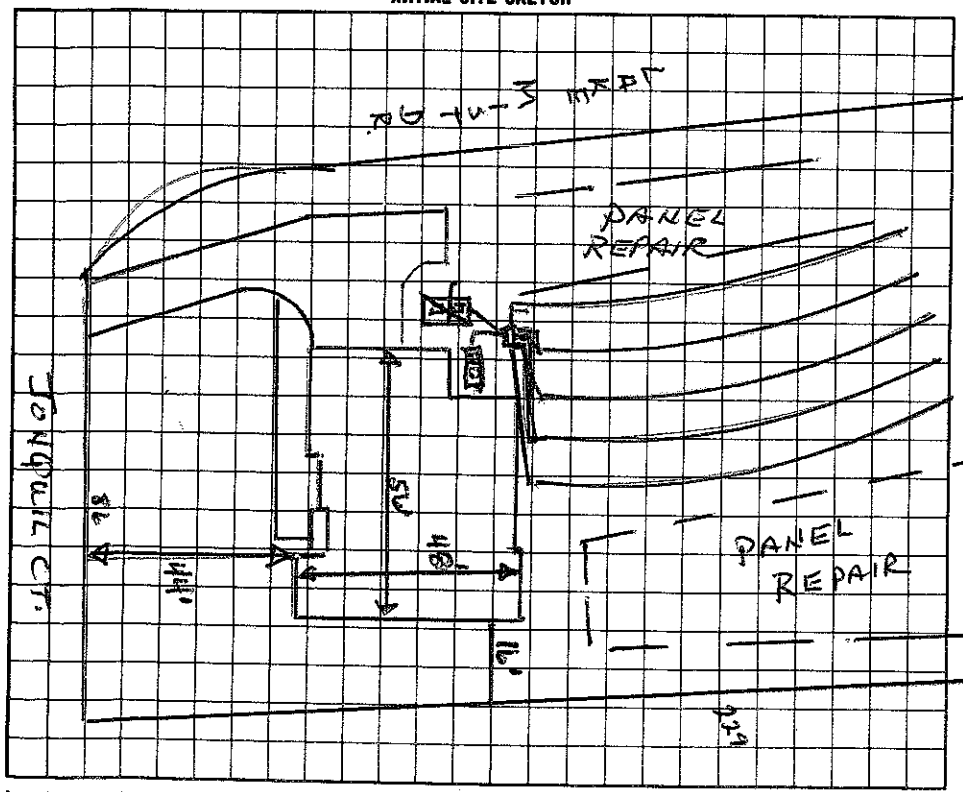

AS BUILT SKETCH

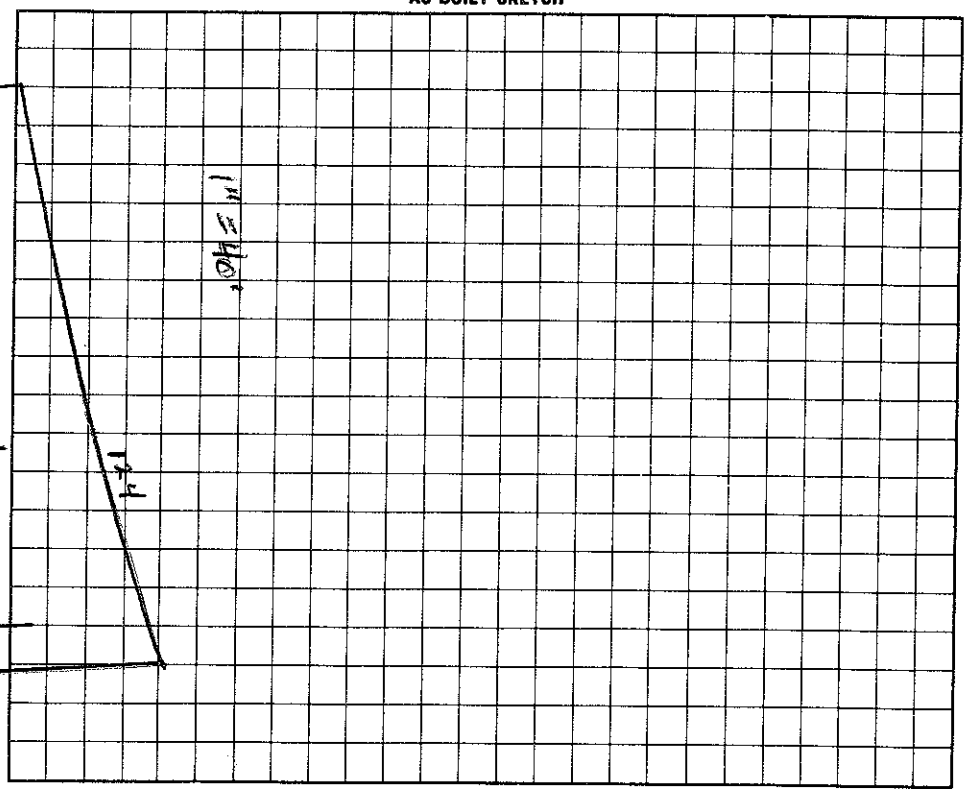

I understand that this permit can be suspended or revoked if any false information is supplied toward securing the permit/any unauthorized changes are made to the site/any unauthorized changes are made in the installation of the system.

Authorization to construct valid 60 months.

Signed: _____ Agent

Improvement Permit by: Wesley Sparks R.S. date 6/26/96

Final Inspection by: Wesley Sparks R.S. date 6/26/96

Installed by: Macleod

Certificate of Completion by: _____ date _____

Operation Permit by: Wesley Sparks R.S. date 11/27/96

HEALTH DEPT. COPY: WHITE INSPECTION COPY (FINAL): GREEN OWNER COPY (FINAL): YELLOW INSPECTION COPY (INITIAL): PINK OWNER COPY (INITIAL): GOLD