IREDELL COUNTY HEALTH DEPARTMENT

Statesville Office (704) 878-5305 Mooresville Office (704) 660-3625 PERMIT # 210916

BH

IMPROVEMENT PERMIT / AUTHORIZATION TO CONSTRUCT / OPERATION PERMIT / EXISTING SYSTEM

PIN # 4676-60-1197.000 ✓

APPLICANT: Russell Post APPLICANT ADDRESS: 6514 Gilead Rd. Huntersville NC

SITE ADDRESS: 105 Tonquil Ct. Mooresville NC PHONE: 704-607-0573 ALT. PHONE: 704-658-5324

SITE DIRECTIONS: 53R, R Bay Harbour R Lakemist, L Tonquil, Corner Lot


SUBDIVISION: The Harbour SECTION: 1 LOT # 1 LOT AREA: .65 acre DESIGN FLOW: Ex. 480 GPD L.T.A.R.: Existing .3

Septic Tank: Existing (gal)	STB	Date	☐ New System ☐ Repair ☐ Expansion	System Type: I II III IV V VI	☑ Residence No. Bedrooms Ex. 4	Water Supply
Pump Tank (gal)	PT	Date	System Description: Existing 75% Red. Gravity		☐ Business No. Persons Ex. 8	☐ Private
Pump Make Model		Serial #	Repair System Description: Existing		☐ Other No. Employees	☐ Public
# Nitrification Fields Ex.	# Lines Existing	Linear Ft: Existing	Maintenance Agreement Required:	☐ YES ☒ NO	☐ Slab ☒ Crawl Space	☒ Community
Trench Width Existing	Max. Trench Bottom Depth Existing	Gravel Depth N/A	☒ GRAVITY	☐ PRESSURE	☐ Basement w/plumbing	☐ Basement w/o plumbing


Comments / Conditions: Existing System Appeared To Be Functioning At Time Of Inspection. Deck Extension Meets Setbacks From Septic. Existing Deck Is 5' From Existing System.

But Steps From Deck Are only 6" From Drainfield. This Permit Is For Approval of Addition only.

INITIAL SITE SKETCH

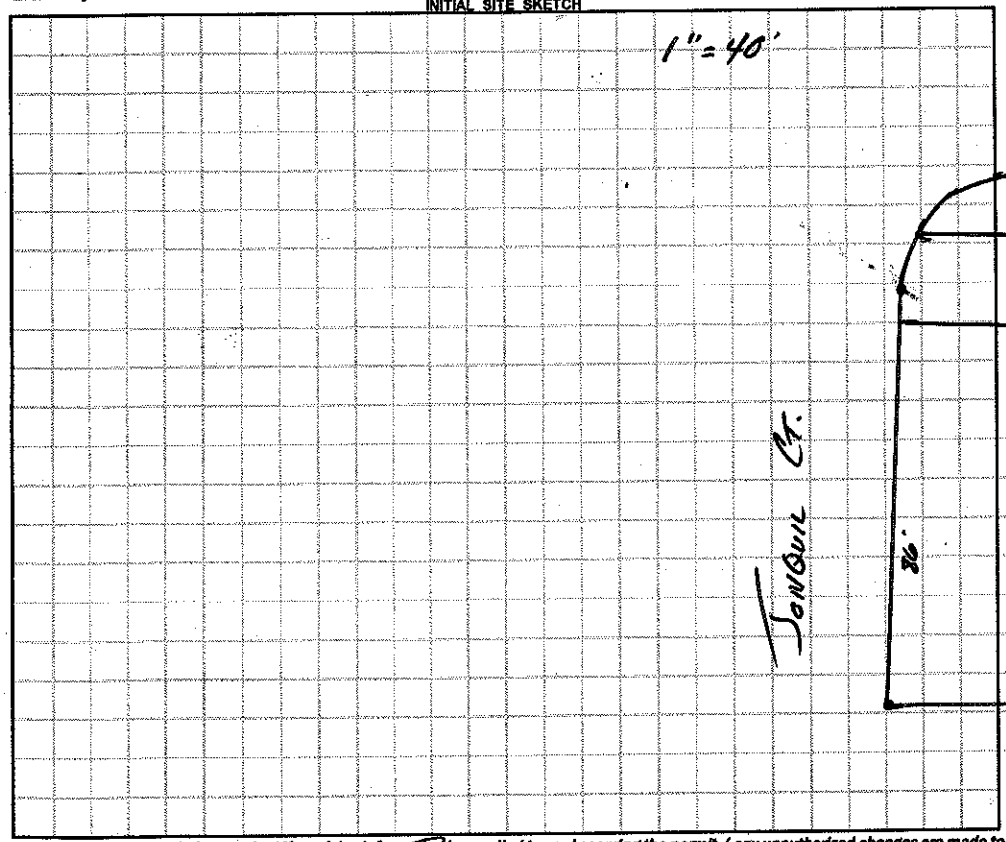

AS BUILT SKETCH

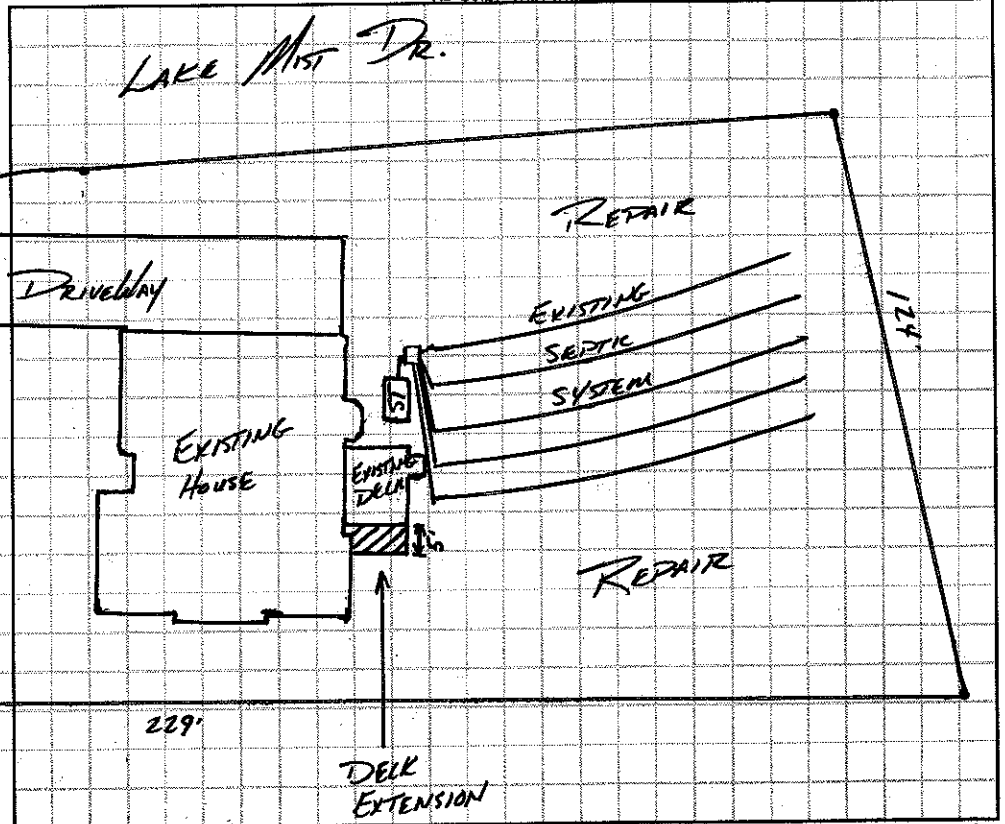

Permit can be suspended or revoked if any false information is supplied toward securing the permit / any unauthorized changes are made to the site / any unauthorized changes are made in the installation of the system. **CONTACT A LOCATOR SERVICE PRIOR TO ANY EXCAVATION**

☐ **IMPROVEMENT PERMIT** *with plat valid without expiration* ☐ **IMPROVEMENT PERMIT** *with site plan valid for 60 mos.* ☐ **AUTHORIZATION TO CONSTRUCT** *valid for period equal to IMPROVEMENT PERMIT--not to exceed 60 mo.*

Owner / Applicant Signature: Date: 6-17-15 Installed by:

IMPROVEMENT PERMIT by: Date: OPERATION PERMIT by: Date:

AUTHORIZATION TO CONSTRUCT by: Date: Existing System Inspected by: APPROVED JUN 17 2015

Health Dept. Copy - WHITE Applicant (Final Approval) - YELLOW Applicant (Conditional Approval) - PINK