IREDELL COUNTY HEALTH DEPARTMENT

Auth. to Const

STATESVILLE 704-878-5305 MOORESVILLE 704-664-5281

IMPROVEMENT PERMIT / ~~CERTIFICATE OF COMPLETION~~ / OPERATION PERMIT / EXISTING SYSTEM INSPECTION

PROPERTY DESCRIPTION NO. 23710 DATE 4/26/96 TAX MAP NO. 2F-12-A-2 Watershed: ☐ ~~Yes~~ ☒ No

OWNER OR CONTRACTOR John Wieland Homes PHONE: Business 704-373-3012 ~~Home~~ 4626-60-2196

ADDRESS 700 S. TRYON St. Charlotte

LOCATION Bowling School - TR Harbour Rd. - TL Lake Mist Dr. - TL Longwood Ct 2nd on Left

SUBDIVISION Harbour I BLOCK / SECTION D LOT 2 LOT AREA _____ SITE CLASS. PS DESIGN FLOW ~~450~~ 360 gpd L.T.A.R. .3 gpd/sq ft

Septic Tank: 1000 Gallons; STB 794 Date 10/12/96

Pump Tank: _____ Gallons; PT _____ Date _____

Pump Make: _____ Model _____ Serial No. _____

Nitrification Field: No Fields 1 Square Feet 1200 Linear Feet 300

No Lines 5 Trench Width 36" Max Trench Bottom Depth 36" Gravel Depth N/A

☑ New System ☐ Repair System Type: I, II, (III), IV, V, VI

System Description: Gravity Chambered

Repair System Description: Gravity Panel

Maintenance Agreement Required: ☐ Yes ☒ No

☑ House/Mod. Home ☐ Mobile Home ☐ Business ☐ Other

No. Bedrooms 4 No. Bathrooms 4 No. Employees _____


☐ Slab ☑ Crawl Space ☐ Basement w/plumbing ☐ Basement wo/plumbing

Water Supply: ☐ Individual ☐ Community ☑ Public

Comments:

Comments: Terra-Mat beginning of Oct. 2003.

INITIAL SITE SKETCH 1"=50'

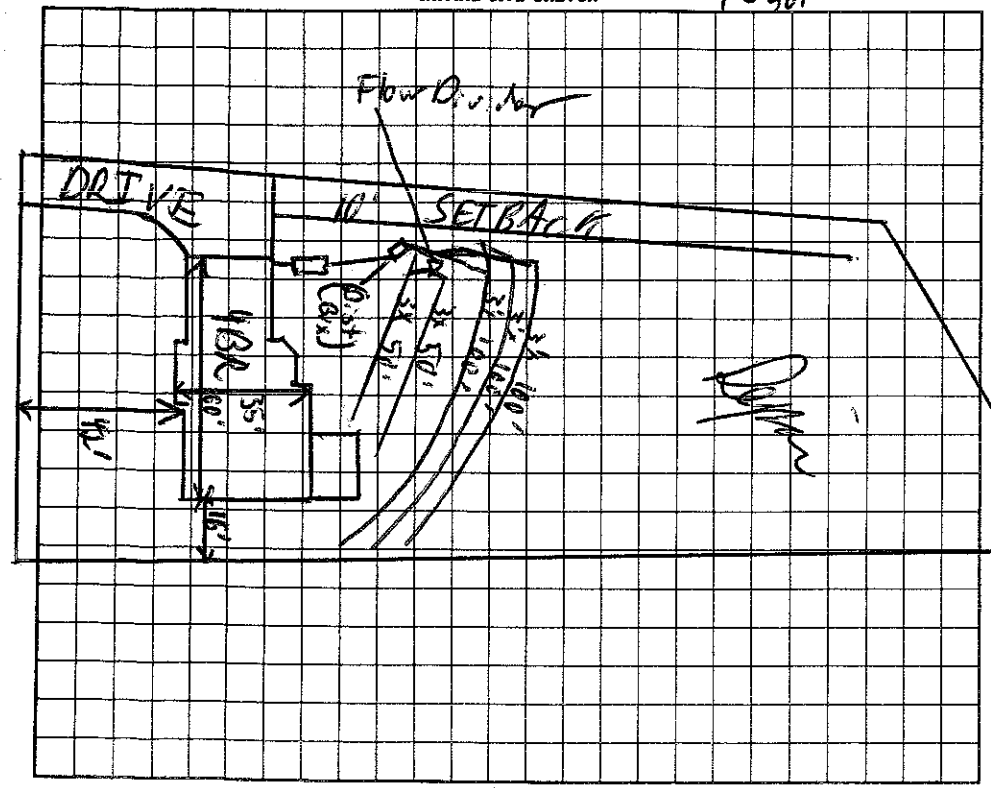

AS BUILT SKETCH

I understand that this permit can be suspended or revoked if any false information is supplied toward securing the permit/any unauthorized changes are made to the site/any unauthorized changes are made in the installation of the system.

Signed: Tony C. Tompkins, CPO Agent

Improvement Permit by: C. Bradsheen EHS date 4/26/96

Authorization to Construct ~~Existing System Inspection~~ by: C. Bradsheen EHS date 4/26/96

Installed by: Marked Const

Certificate of Completion by: _____ date _____

Operation Permit by: Wesley Sparks RS date 1/8/97

HEALTH DEPT. COPY: WHITE INSPECTION COPY (FINAL): GREEN OWNER COPY (FINAL): YELLOW INSPECTION COPY (INITIAL): PINK OWNER COPY (INITIAL): GOLD

Authorization to Construct is Valid for 12 months from issue date