4626602748

IREDELL COUNTY HEALTH DEPARTMENT

STATESVILLE 704-878-5305 MOORESVILLE 704-664-5281

IMPROVEMENT PERMIT / CERTIFICATE OF COMPLETION / OPERATION PERMIT / EXISTING SYSTEM INSPECTION

PROPERTY DESCRIPTION NO. Repair DATE 8/16/96 TAX MAP NO. REPAIR Watershed: ☑ Yes ☐ No

OWNER OR CONTRACTOR Donnie Hager PHONE: Business Home 664-5027

ADDRESS 181 CHUCKWOOD

LOCATION 181 CHUCKWOOD - BRAWLEY SCHOOL RD - TR CHUCKWOOD - ON LEFT

SUBDIVISION — BLOCK / SECTION — LOT — LOT AREA SITE CLASS. DESIGN FLOW L.T.A.R.

Septic Tank: Existing Gallons; STB Date

Pump Tank: Gallons; PT Date

Pump Make: Model Serial No.

Nitrification Field: No Fields 1 Square Feet 900 Linear Feet 300

No Lines 3 Trench Width 36" Max Trench Bottom Depth ≈24" Gravel Depth 12"

☑ New System ☐ Repair System Type: I II III IV V VI

System Description: GRAVITY CONV

Repair System Description:

Maintenance Agreement Required: ☐ Yes ☐ No

☑ House/Mod. Home No. Bedrooms 3

☐ Mobile Home No. Bathrooms 2

☐ Business No. Employees

☐ Other

☐ Slab ☑ Crawl Space ☐ Basement w/plumbing ☐ Basement wo/plumbing


Water Supply: ☑ Individual ☐ Community ☐ Public

Comments:

Comments:

CHUCKWOOD RD

INITIAL SITE SKETCH

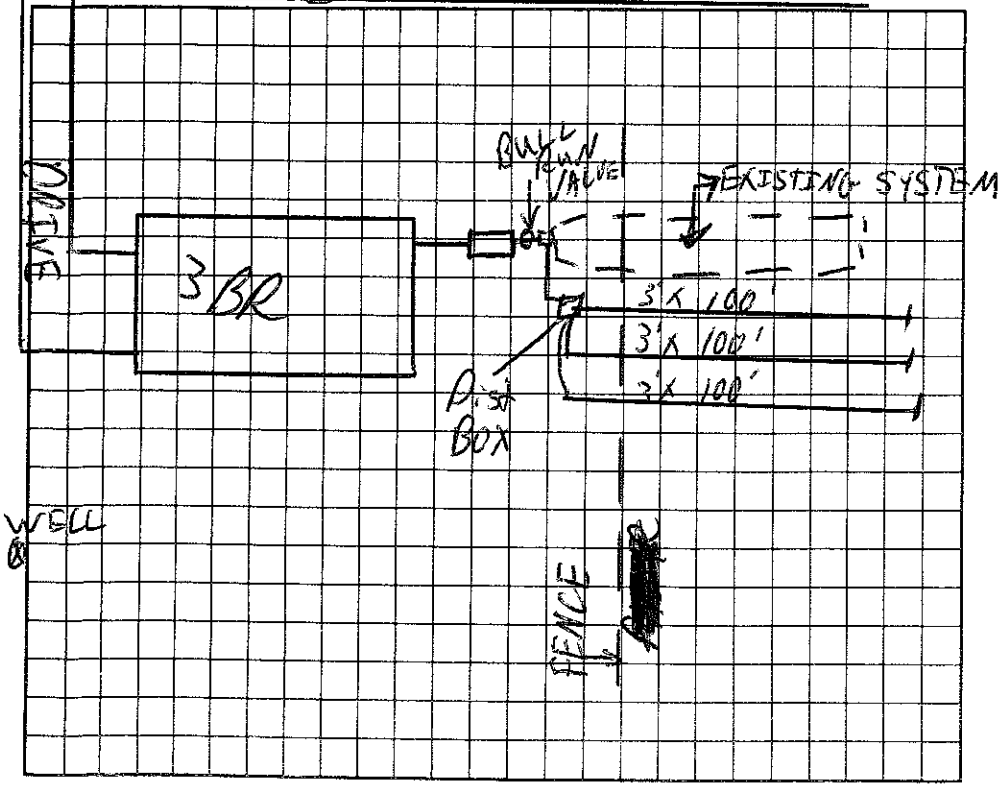

AS BUILT SKETCH

I understand that this permit can be suspended or revoked if any false information is supplied toward securing the permit/any unauthorized changes are made to the site/any unauthorized changes are made in the installation of the system.

Signed:

Improvement Permit by: C. Ray Thompson date 8/16/96

Existing System Inspection by: C. Ray Thompson date 8/16/96

Installed by: Barry T Thompson

Certificate of Completion by: date

Operation Permit by: Wesley Sparks RS. date 8/27/96

HEALTH DEPT. COPY: WHITE INSPECTION COPY (FINAL): GREEN OWNER COPY (FINAL): YELLOW INSPECTION COPY (INITIAL): PINK OWNER COPY (INITIAL): GOLD