IREDELL COUNTY HEALTH DEPARTMENT

Statesville Office (704) 878-5305 Mooresville Office (704) 660-3625 PERMIT # 220793

BA

IMPROVEMENT PERMIT / AUTHORIZATION TO CONSTRUCT / OPERATION PERMIT / EXISTING SYSTEM

PIN # 4626604771 ✓

APPLICANT: Grady Mayhew APPLICANT ADDRESS: 149 Chuckwood Mooresville, NC 28117

SITE ADDRESS: 108 Mayhew Park Ln Mooresville PHONE: ALT. PHONE: 704-763-7224

SITE DIRECTIONS: Brawley School Rd TR Chuckwood TL Mayhew Park Ln follow paved drive on left

SUBDIVISION: Grady Mayhew Park SECTION: LOT # 4 LOT AREA: ±7 Ac DESIGN FLOW: 2 bdrm L.T.A.R.:

Exist

Septic Tank 1000 (gal) STB Date

Pump Tank (gal) PT Date

Pump Make Model Serial #

Nitrification Fields 1 # Lines 3 Linear Ft: 240'

Trench Width Exist Max. Trench Bottom Depth Exist Gravel Depth 12"

☐ New System ☐ Repair ☐ Expansion System Type: I II III IV V VI

System Description: Exist. Gravity-Conventional

Repair System Description: Same

Maintenance Agreement Required: ☐ YES ☒ NO

☒ GRAVITY ☐ PRESSURE

☒ Residence No. Bedrooms 2

☐ Business No. Persons 4

☐ Other No. Employees

☐ Slab ☒ Crawl Space


☐ Basement w/plumbing ☐ Basement w/o plumbing

Water Supply: ☐ Private ☐ Public ☒ Community

Comments / Conditions: Keep Septic System 10ft from Septic System (if no drain 5ft)

Septic System appears to be functioning okay at time of Inspection

INITIAL SITE SKETCH

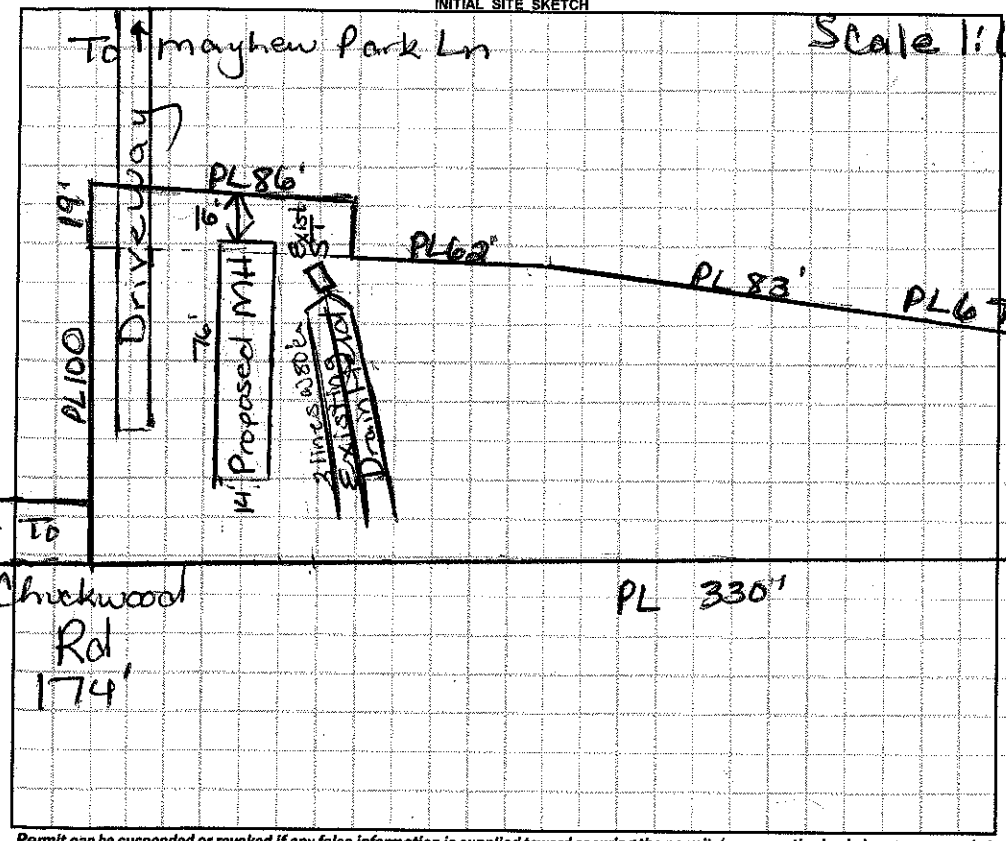

AS BUILT SKETCH

Permit can be suspended or revoked if any false information is supplied toward securing the permit / any unauthorized changes are made to the site / any unauthorized changes are made in the installation of the system. **CONTACT A LOCATOR SERVICE PRIOR TO ANY EXCAVATION**

☐ **IMPROVEMENT PERMIT** *with plat valid without expiration.* ☐ **IMPROVEMENT PERMIT** *with site plan valid for 60 mos.* ☐ **AUTHORIZATION TO CONSTRUCT** *valid for period equal to IMPROVEMENT PERMIT--not to exceed 60 mo.*

Owner / Applicant Signature: Grady Mayhew Date: 9-21-16 Installed by:

IMPROVEMENT PERMIT by: Date: OPERATION PERMIT by: Date:

AUTHORIZATION TO CONSTRUCT by: Date: Existing System Inspected by: Maria Dotson Date: 9/20/16

Health Dept. Copy - WHITE Applicant (Final Approval) - YELLOW Applicant (Conditional Approval) - PINK