IREDELL COUNTY HEALTH DEPARTMENT

Statesville Office (704) 878-5305 Mooresville Office (704) 660-3625 RA

PERMIT # 220794

IMPROVEMENT PERMIT / AUTHORIZATION TO CONSTRUCT / OPERATION PERMIT / EXISTING SYSTEM

PIN # 4626604902

APPLICANT: Grady Mayhew APPLICANT ADDRESS: 149 Chuckwood Mooresville, NC 28117

SITE ADDRESS: 167 Chuckwood - Mooresville NC PHONE: 704 763 - 7224 ALT. PHONE:

SITE DIRECTIONS: Brawley School Rd TR Chuckwood ~1/4 mile on left just past Mayhew Park Ln.

SUBDIVISION: Grady Mayhew Park SECTION: LOT # 1 LOT AREA: .42 Ac DESIGN FLOW: 360 gpd L.T.A.R:

Septic Tank 1000 (gal) STB Date

Pump Tank (gal) PT Date

Pump Make Model Serial #

Nitrification Fields Existing # Lines Linear Ft:

Trench Width Max. Trench Bottom Depth Gravel Depth

☐ New System ☑ Repair ☐ Expansion System Type: I II III IV V VI

System Description: Existing Gravity-Conventional

Repair System Description: Exempt

Maintenance Agreement Required: ☐ YES ☒ NO

☒ GRAVITY ☐ PRESSURE

☒ Residence No. Bedrooms 3

☑ Business No. Persons 6

☐ Other No. Employees

☐ Slab ☒ Crawl Space


☐ Basement w/plumbing ☐ Basement w/o plumbing

Water Supply: ☐ Private ☐ Public ☒ Community

Comments / Conditions: Existing Septic System "appeared" to be functioning okay at time of inspection

Keep new home at least 10ft from Septic System.

INITIAL SITE SKETCH

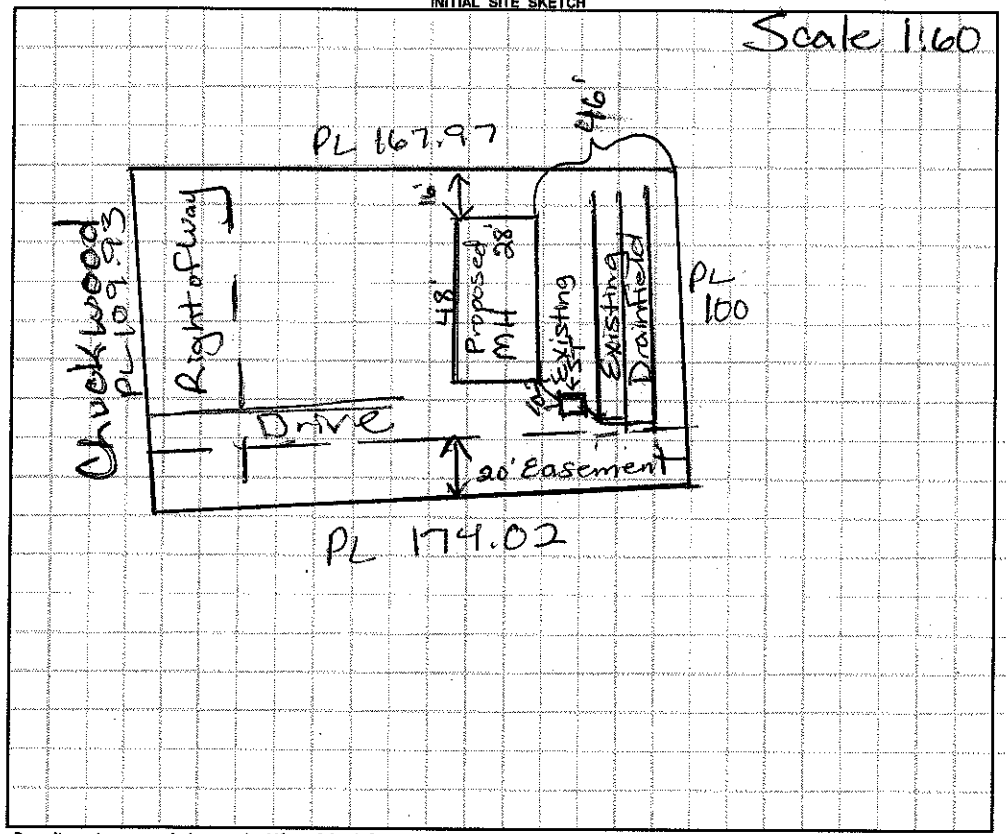

AS BUILT SKETCH

Permit can be suspended or revoked if any false information is supplied toward securing the permit / any unauthorized changes are made to the site / any unauthorized changes are made in the installation of the system. **CONTACT A LOCATOR SERVICE PRIOR TO ANY EXCAVATION**

☐ **IMPROVEMENT PERMIT** *with plat valid without expiration.* ☐ **IMPROVEMENT PERMIT** *with site plan valid for 60 mos.* ☐ **AUTHORIZATION TO CONSTRUCT** *valid for period equal to IMPROVEMENT PERMIT--not to exceed 60 mo.*

Owner / Applicant Signature: Grady Mayhew Date: 9-22-16 Installed by:

IMPROVEMENT PERMIT by: Date: OPERATION PERMIT by: Date:

AUTHORIZATION TO CONSTRUCT by: Date: Existing System Inspected by: Maina Dotson RS Date: 9/16/16

Health Dept. Copy - WHITE Applicant (Final Approval) - YELLOW Applicant (Conditional Approval) - PINK