IREDELL COUNTY HEALTH DEPARTMENT

Authorization to Construct — 300

STATESVILLE 704-878-5305 — MOORESVILLE 704-664-5281

IMPROVEMENT PERMIT / ~~CERTIFICATE OF COMPLETION~~ / OPERATION PERMIT / EXISTING SYSTEM INSPECTION

PROPERTY DESCRIPTION NO. 8381 DATE 3/19/97 TAX MAP NO. Pt of 2C A 3 Watershed: X Yes ☐ No

OWNER OR CONTRACTOR John Wieland Homes PHONE: Business 663-6905 Home 4626 60 5294

ADDRESS 400 S Tryon St, Charlotte NC. 28201

LOCATION 1100 TR Bay Harbour TL Lake Mist TL Jangum Ct on (L) just before Cul de Sac.

SUBDIVISION Harbour BLOCK / SECTION I LOT 4 LOT AREA 1.64AC SITE CLASS PS DESIGN FLOW 480 L.T.A.R. .3

Septic Tank: 1000 Gallons; STB 794 Date 1-15-97

Pump Tank: 1000 Gallons; PT 37 Date 2-13-97

Pump Make: Model Serial No.

Nitrification Field: No Fields 1 Square Feet 1200 ✱ Linear Feet 480 ✱

No Lines 6 Trench Width 36" Max Trench Bottom Depth 30" Gravel Depth SAND

X New System ☐ Repair System Type: I, II, III, IV, V, VI

System Description: Pres Mon — Ch. Plastic

Repair System Description: PANEL 16"

Maintenance Agreement Required: X Yes ☐ No

X House/Mod. Home ☐ Mobile Home ☐ Business ☐ Other

No. Bedrooms 4 No. Bathrooms 4 No. Employees

☐ Slab ☐ Crawl Space X Basement w/plumbing ☐ Basement wo/plumbing


Water Supply: ☐ Individual X Community ☐ Public

Comments: ✱ Changed to Chamberlend Plastic


Comments:

1" = 50'

INITIAL SITE SKETCH

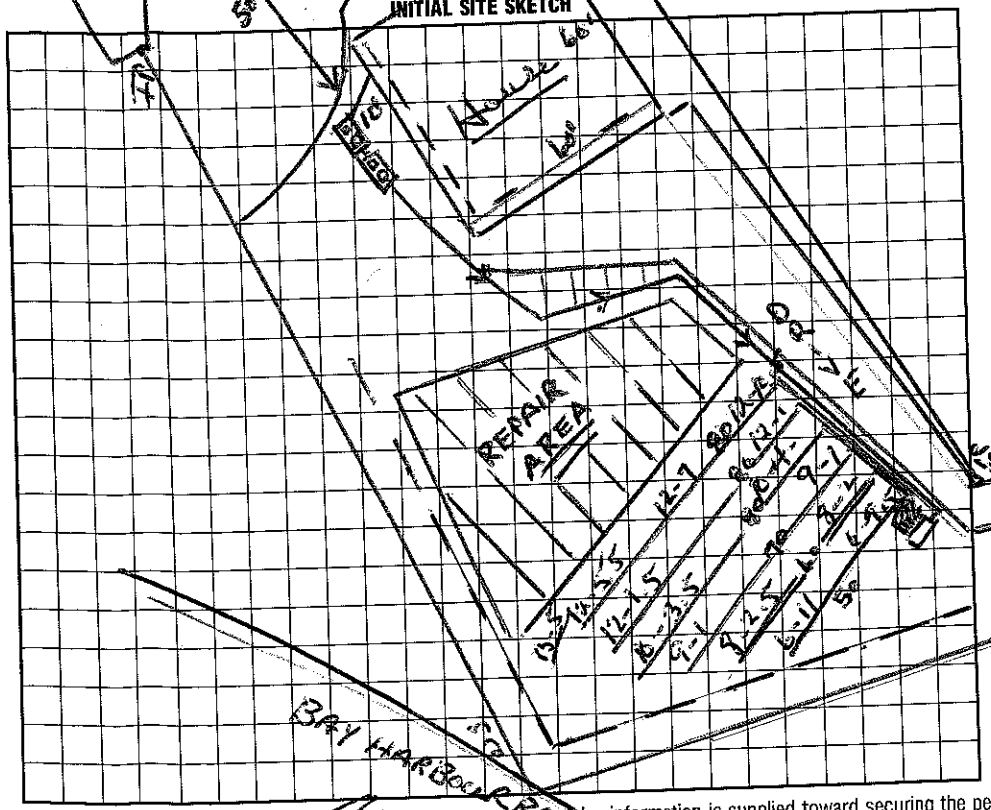

AS BUILT SKETCH

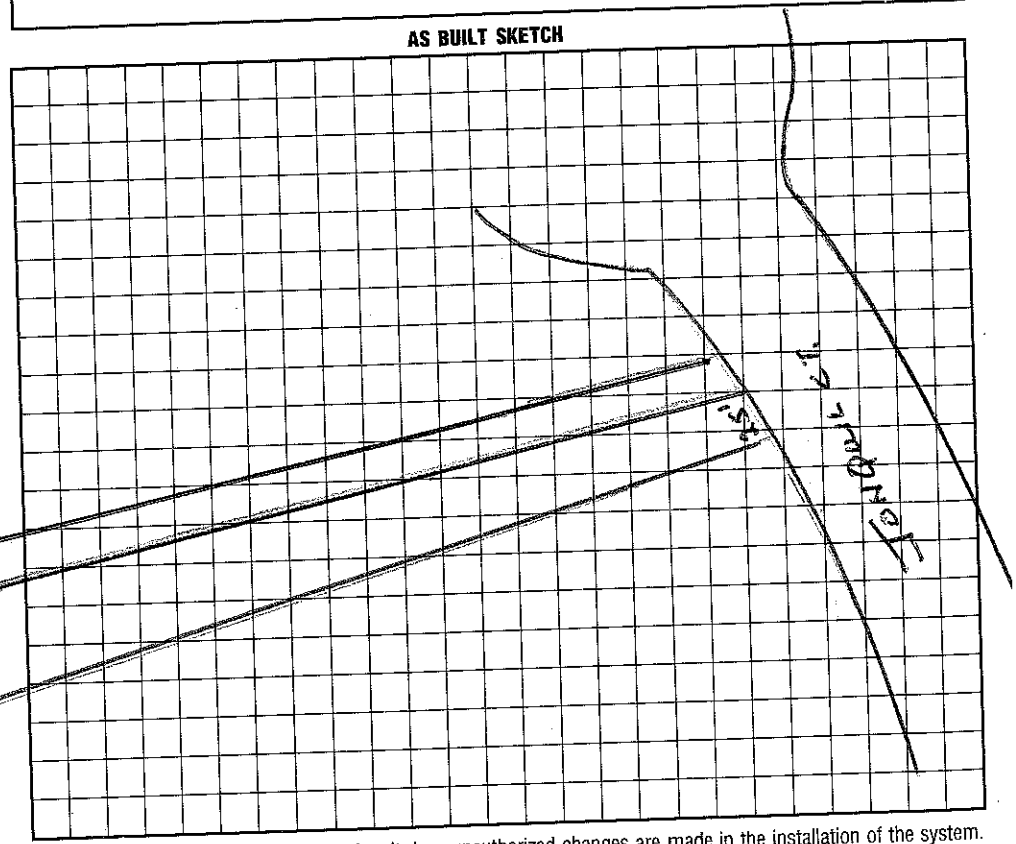

I understand that this permit can be suspended or revoked if any false information is supplied toward securing the permit/any unauthorized changes are made to the site/any unauthorized changes are made in the installation of the system.

Signed: ✱ Installed by: Macleod

Improvement Permit by: Wesley Sparks R.S. date 3/19/97

Certificate of Completion by: date

Operation Permit by: Wesley Sparks R.S. date 3/19/97

Operation Permit by: C. [illegible] date 7/25/97

INSPECTION COPY (FINAL): GREEN OWNER COPY (FINAL): YELLOW INSPECTION COPY (INITIAL): PINK OWNER COPY (INITIAL): GOLD