4626 60 6089

IREDELL COUNTY HEALTH DEPARTMENT

STATESVILLE 704-878-5305 MOORESVILLE 704-664-5281

IMPROVEMENT PERMIT / CERTIFICATE OF COMPLETION / OPERATION PERMIT / EXISTING SYSTEM INSPECTION

PROPERTY DESCRIPTION NO. 18382 DATE 4/17/96 TAX MAP NO. PT of 2C A 3 Watershed: [X] Yes [ ] No

OWNER OR CONTRACTOR John Wieland Homes PHONE: Business 664-5966 Home

ADDRESS 8325 Arrowridge Blvd. Charlotte, NC. 28273

LOCATION Bay Harbour (L) Lake Mist (L) Jonquil to cul de sac (L) driveway

SUBDIVISION Harbour BLOCK / SECTION 1 LOT 5 LOT AREA ~ 21,780 SITE CLASS. PS1 DESIGN FLOW 600 L.T.A.R. .3

Septic Tank: 1500 Gallons; STB Date

Pump Tank: 1500 Gallons; PT Date

Pump Make: Model Serial No.

Nitrification Field: No Fields 1 Square Feet 2000 Linear Feet 330

No Lines 5 Trench Width 24" Max Trench Bottom Depth 36" Gravel Depth 6" STONE

[X] New System [ ] Repair System Type: I. II. III. IV. V. VI

System Description: Presa - Panel 46"

Repair System Description: Same

Maintenance Agreement Required: [X] Yes [ ] No

[X] House/Mod. Home No. Bedrooms 5

[ ] Mobile Home No. Bathrooms 4

[ ] Business No. Employees

[ ] Other


[ ] Slab [ ] Crawl Space [X] Basement w/plumbing [ ] Basement wo/plumbing

Water Supply: [ ] Individual [X] Community [ ] Public


Comments:

Comments:

INITIAL SITE SKETCH

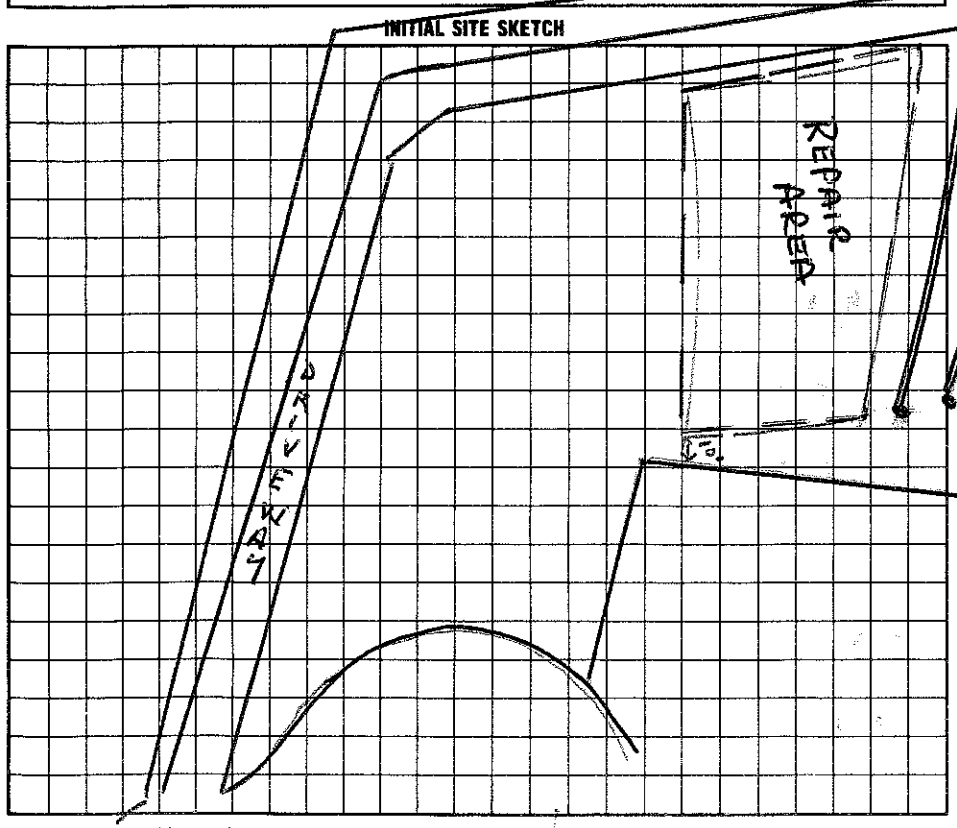

AS BUILT SKETCH

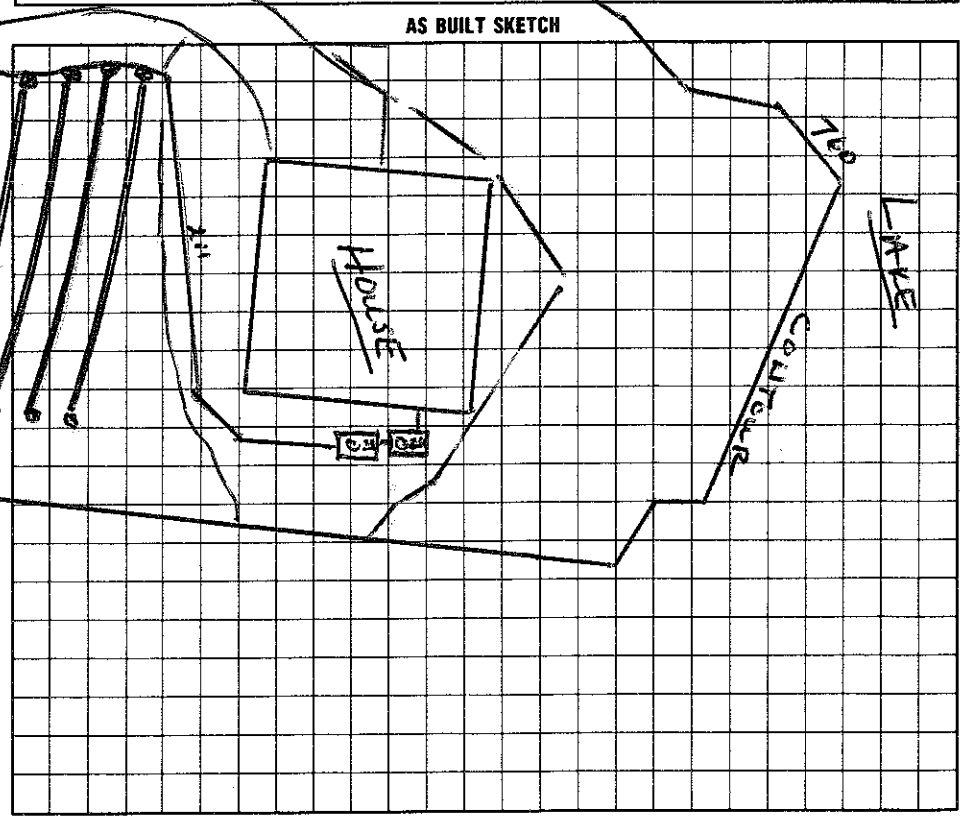

I understand that this permit can be suspended or revoked if any false information is supplied toward securing the permit/any unauthorized changes are made to the site/any unauthorized changes are made in the installation of the system.

Signed:

Installed by: MacLeod Const. Co.

Improvement Permit by: date

Certificate of Completion by: date

Existing System Inspection by: date

Operation Permit by: Wesley Sparks RS. date 4/17/96

HEALTH DEPT. COPY: WHITE INSPECTION COPY (FINAL): GREEN OWNER COPY (FINAL): YELLOW INSPECTION COPY (INITIAL): PINK OWNER COPY (INITIAL): GOLD