IREDELL COUNTY HEALTH DEPARTMENT

STATESVILLE 704-878-5305 MOORESVILLE 704-664-5281

IMPROVEMENT PERMIT / AUTHORIZATION TO CONSTRUCT / OPERATION PERMIT / EXISTING SYSTEM INSPECTION

345 Rt past house across street 7030

PERMIT# 112568 PIN# 4626663734 5 4626-61-4519 DATE 2-24-05

OWNER OR CONTRACTOR The Hoke Company PHONE: Business 799-7495 Home 799-2657

ADDRESS P.O. Box 4448 Mooresville NC 28117

LOCATION Brawley School Rd JR South Fork TL Freshwater on right near end

SUBDIVISION The Farms BLOCK / SECTION 2 LOT 241 LOT AREA .98+ SITE CLASS PS DESIGN FLOW 600 gpd L.T.A.R. .25

Septic Tank: 1500 Gallons; STB 338 Date 6-28-05 ☒ New System ☐ Repair System Type: I, II, III, IV, V, VI

Pump Tank: 1500 Gallons; PT 477 Date 6-20-05 System Description: Pump-Offsite-50% Reduction

Pump Make: Goulds Model P102 Serial No. Repair System Description: Pump-LP-Panel Blk (Off site)

Nitrification Field: No Fields 1 Square Feet 1200 Linear Feet 400' Maintenance Agreement Required: ☐ Yes ☐ No

No Lines 5 @ 80' Trench Width 24"-36" Max Trench Bottom Depth 36" Gravel Depth N/A ☐ Slab ☐ Crawl Space ☒ Basement w/plumbing ☐ Basement wo/plumbing


☒ House/Mod. Home ☐ Mobile Home ☐ Business ☐ Other No. Bedrooms 5 No. Bathrooms 4 No. Employees

Water Supply: ☐ Individual ☒ Public ☒ Community

Comments:/Conditions: See Color Coded Plat for Supply line Easement.
Any Future pool must be at least 15' from Septic tank & pump tank

Comments:/Conditions: Lines Checked by GM 4/19/05
Pressure, elect & alarm 10/27/05 MS

INITIAL SITE SKETCH Scale 1"=50'

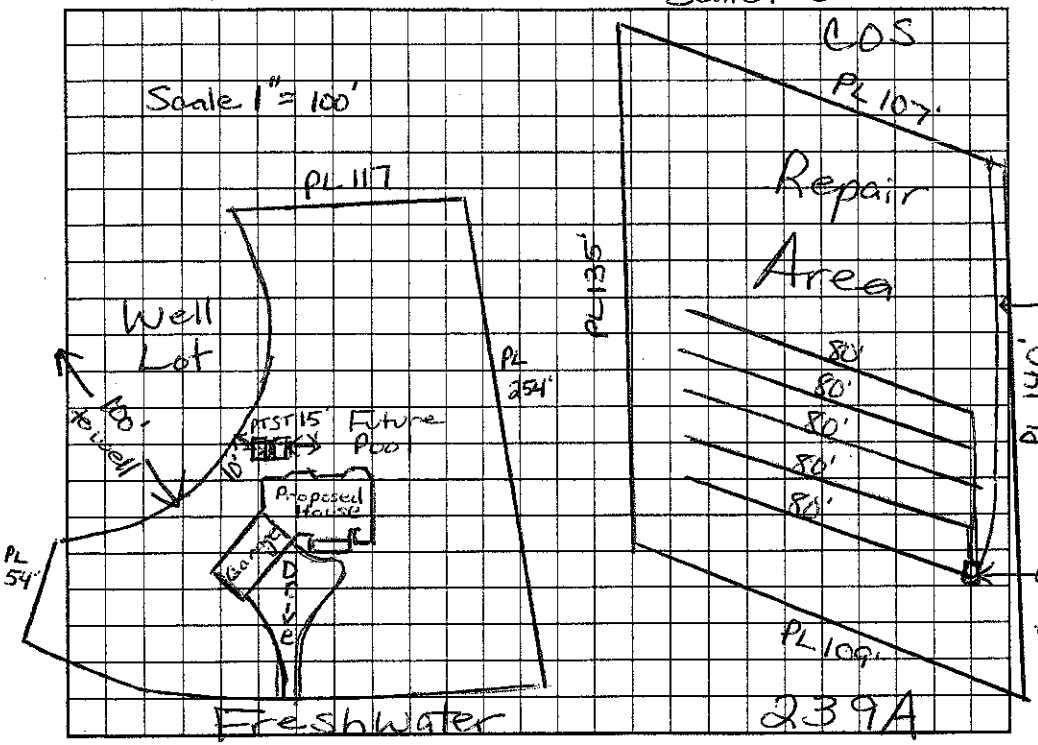

AS BUILT SKETCH

Permit can be suspended or revoked if any false information is supplied toward securing the permit/any unauthorized changes are made to the site/any unauthorized changes are made in the installation of the system. Improvement Permit with plat valid without expiration. Improvement Permit with site plan valid for sixty months. Authorization to Construct is valid for a period equal to that of Improvement Permit – not to exceed sixty months.

Signed: Marjorie Hoke date

Improvement Permit by: Marjorie Hoke Dolan RS date 2/24/05

Authorization to Construct by: Marjorie Hoke Dolan RS date 2/24/05

Installed by: R+H date

Operation Permit by: Marjorie Hoke Dolan RS date 10/27/05

Existing System Inspection by: date

HEALTH DEPT. COPY: WHITE OWNER COPY (FINAL): YELLOW OWNER COPY (INITIAL): PINK