IREDELL COUNTY HEALTH DEPARTMENT

STATESVILLE 704-878-5305 | 130 MOORESVILLE 704-664-5281

IMPROVEMENT PERMIT / AUTHORIZATION TO CONSTRUCT / OPERATION PERMIT / EXISTING SYSTEM INSPECTION

PERMIT# 112 558 PIN# 4626637315.238 4626-61-4809 DATE 8/8/03

OWNER OR CONTRACTOR CRESCENT RESOURCES / Jasper Bldr. PHONE: Business 660-1185 Home

ADDRESS 2214 BRAWLEY SCHOOL - MOORESVILLE NC 28117

LOCATION BRAWLEY SCHOOL - TR SOUTHFORK - TL FRESHWATER - TR HOSKINS CT - AT END

SUBDIVISION THE FARMS BLOCK / SECTION 2 LOT 238 LOT AREA .784c SITE CLASS. RS DESIGN FLOW 480GPD L.T.A.R. .300/FT2

Septic Tank: 1500 Gallons; STB 338 Date 3/24/06

Pump Tank: 1000 Gallons; PT 27 Date 6/28/06

Pump Make: Goulds Model ~~WE1512HM~~ Serial No.

Nitrification Field: No Fields 1 Square Feet 1200 Linear Feet 400

No Lines 5@80' Trench Width 36" Max Trench Bottom Depth 36" Gravel Depth N/A

☑ New System ☐ Repair System Type: I, II, III, IV, V, VI

System Description: PUMP OFFSITE 25% REDUCTION

Repair System Description: SAME

Maintenance Agreement Required: ☐ Yes ☑ No

☑ House/Mod. Home No. Bedrooms 4

☐ Mobile Home No. Bathrooms 4

☐ Business No. Employees

☐ Other


☐ Slab ☑ Crawl Space ☑ Basement w/plumbing ☐ Basement wo/plumbing

Water Supply: ☐ Individual ☐ Public ☑ ~~Community~~


Comments:/Conditions:

Comments:/Conditions:

INITIAL SITE SKETCH

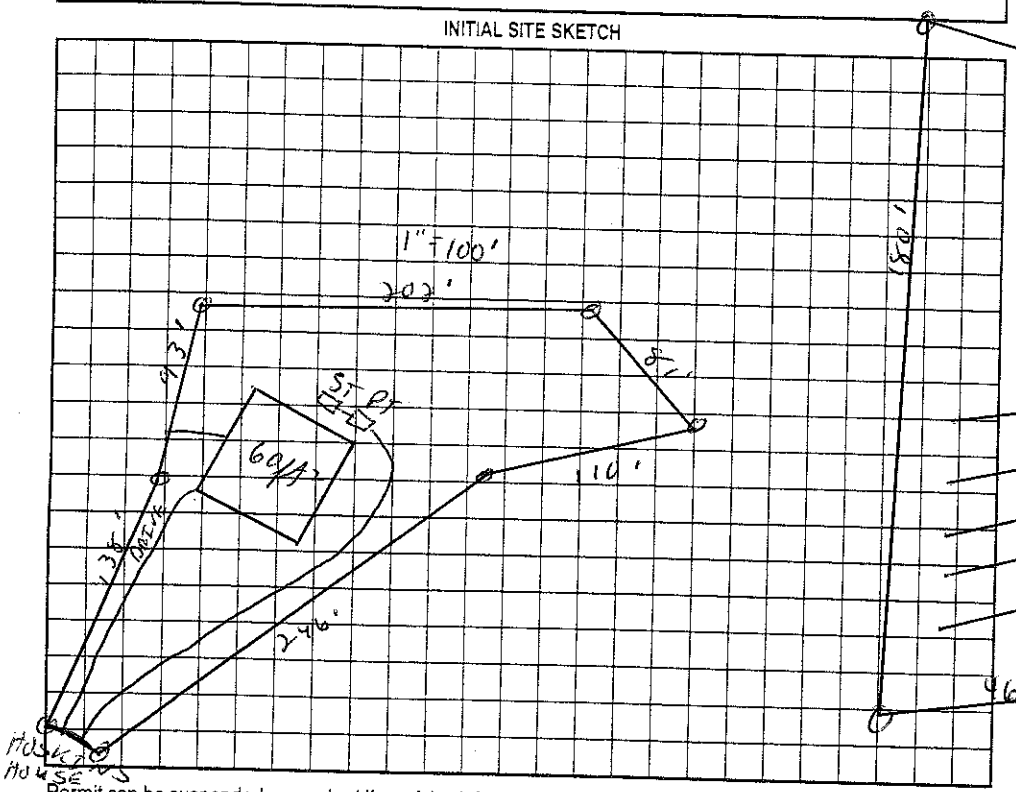

AS BUILT SKETCH

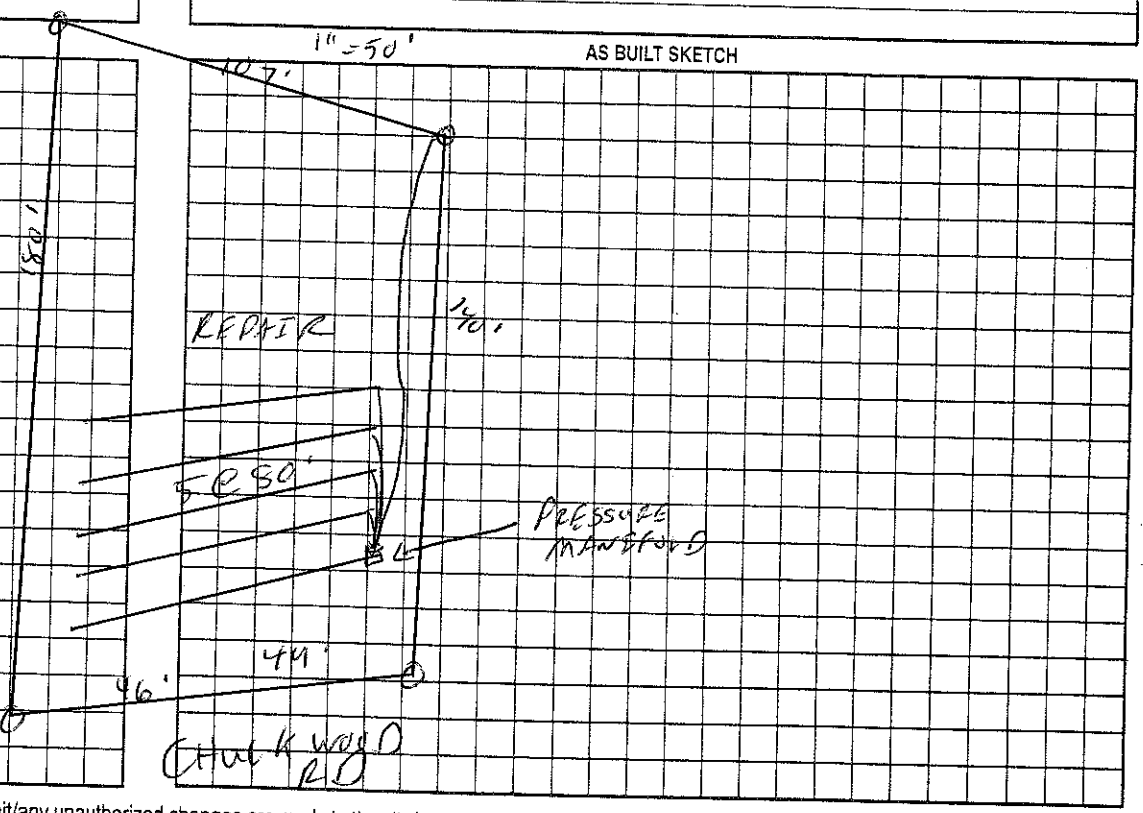

Permit can be suspended or revoked if any false information is supplied toward securing the permit/any unauthorized changes are made to the site/any unauthorized changes are made in the installation of the system. Improvement Permit with plat valid without expiration. Improvement Permit with site plan valid for sixty months. Authorization to Construct is valid for a period equal to that of Improvement Permit – not to exceed sixty months.

Signed: date 8-22-03 Installed by: A Bernath

Improvement Permit by: RS date 8/8/03 Operation Permit by: date 11/9/06

Authorization to Construct by: RS date 2/16/06 Existing System Inspection by: date

HEALTH DEPT. COPY: WHITE OWNER COPY (FINAL): YELLOW OWNER COPY (INITIAL): PINK