IREDELL COUNTY HEALTH DEPARTMENT

STATESVILLE 704-878-5305 MOORESVILLE 704-664-5281

375 10:00

IMPROVEMENT PERMIT / AUTHORIZATION TO CONSTRUCT / OPERATION PERMIT / EXISTING SYSTEM INSPECTION

PERMIT# 112565 PIN# ~~4626637315240~~ 4626-61-5711 DATE 8/12/03

OWNER OR CONTRACTOR CRESCENT RESOURCES / Shaun Ogden Const. PHONE: Business 660-1185 Home

ADDRESS 2214 BRAWLEY SCHOOL - MOORESVILLE 28117

LOCATION BRAWLEY SCHOOL - TR SOUTH FORK - TL FRESHWATER - ON RT Easement on Chec[illegible]

SUBDIVISION THE FARMS BLOCK / SECTION 2 LOT 240 LOT AREA .854C SITE CLASS. PS DESIGN FLOW 480 GPD L.T.A.R. .2560 IP

Septic Tank: 1000 Gallons; STB 338 Date 11-20-05

Pump Tank: 1000 Gallons; PT 283 Date 11-5-05

Pump Make: Zoeller Model WE1512H Serial No.

Nitrification Field: No Fields 1 Square Feet 700 Linear Feet 350

No Lines 5@70' Trench Width 24" Max Trench Bottom Depth 36" Gravel Depth

☑ New System ☐ Repair System Type: I, II, III, IV, V, VI

System Description: LP PANEL OFFSITE

Repair System Description: SAME

Maintenance Agreement Required: ☑ Yes ☐ No

☑ House/Mod. Home No. Bedrooms 4

☐ Mobile Home No. Bathrooms 4

☐ Business No. Employees

☐ Other


☐ Slab ☐ Crawl Space ☑ Basement w/plumbing ☐ Basement wo/plumbing

Water Supply: ☐ Individual ☐ Public ☑ ~~Community~~


Comments:/Conditions: SEE COLOR CODED PLAT FOR SUPPLY LINE EASEMENT

Comments:/Conditions: Checked Panel lines 1/9/06 MD
Marked tanks 1/9/06 MD
Pressure, elect & alarm 2/2/06 MD

1"=100' INITIAL SITE SKETCH

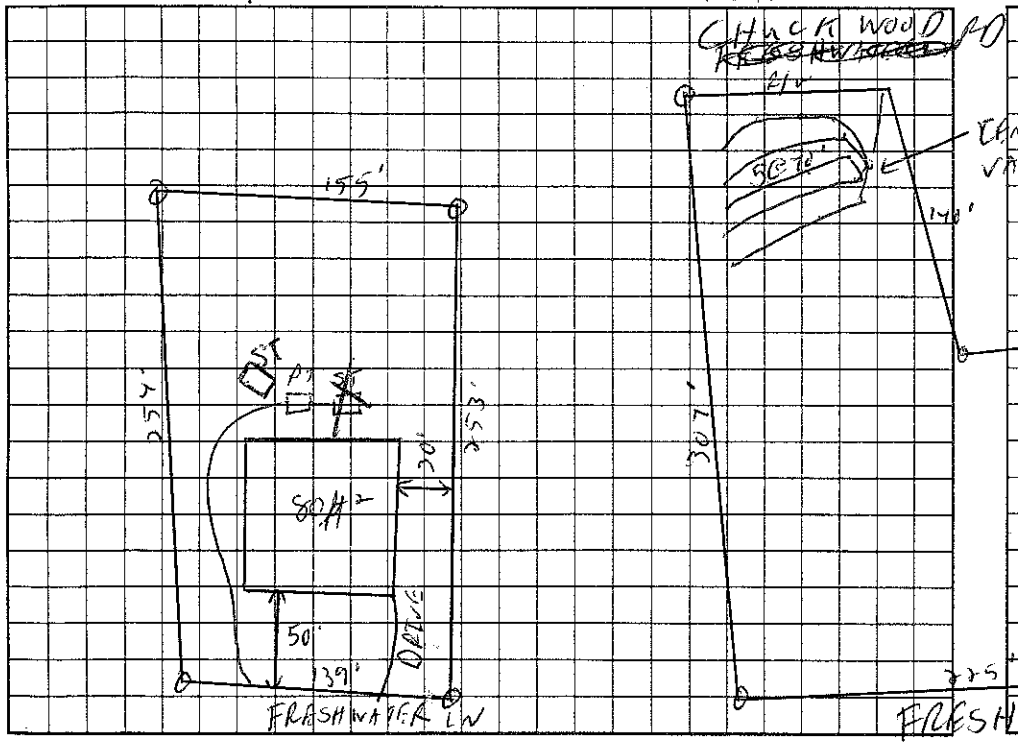

1"=100' AS BUILT SKETCH

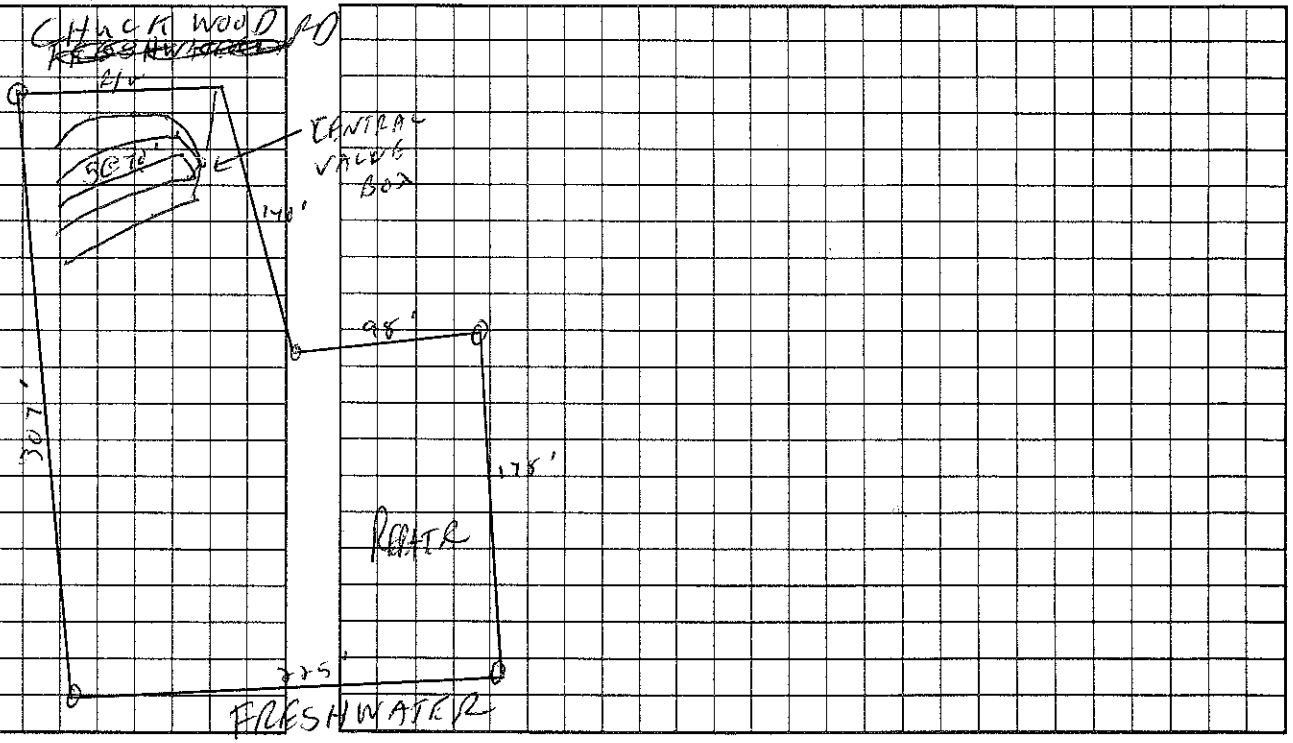

Permit can be suspended or revoked if any false information is supplied toward securing the permit/any unauthorized changes are made to the site/any unauthorized changes are made in the installation of the system. Improvement Permit with plat valid without expiration. Improvement Permit with site plan valid for sixty months. Authorization to Construct is valid for a period equal to that of Improvement Permit – not to exceed sixty months.

Signed: _____ date 9-25-03 Installed by: Richard Abernathy RS

Improvement Permit by: _____ RS date 8/12/03 Operation Permit by: _____ RS date 2/2/06

Authorization to Construct by: _____ RS date 9/20/05 Existing System Inspection by: _____ date _____

HEALTH DEPT. COPY: WHITE OWNER COPY (FINAL): YELLOW OWNER COPY (INITIAL): PINK