IREDELL COUNTY HEALTH DEPARTMENT

STATESVILLE 704-878-5305 MOORESVILLE 704-664-5281

IMPROVEMENT PERMIT / AUTHORIZATION TO CONSTRUCT / OPERATION PERMIT / EXISTING SYSTEM INSPECTION

130

PERMIT# 112564 PIN# 4626637315.239 4626616832 DATE 8/10/03

OWNER OR CONTRACTOR CRESCENT RESOURCES/Hughes, Homelink & Ponder PHONE: Business 660-1155 Home

ADDRESS 2214 BRAWLEY SCHOOL - MOORESVILLE NC 28117

LOCATION BRAWLEY SCHOOL - TR SOUTH FORK - TL FRESHWATER - CORNER OF HOSKINS.

SUBDIVISION THE FARMS BLOCK / SECTION 2 LOT 239 LOT AREA .99AC SITE CLASS. PS DESIGN FLOW 480GPD L.T.A.R. ~.36/.42

Septic Tank: 1000 Gallons; STB 338 Date 5&6-15-05

Pump Tank: 1000 Gallons; PT 37 Date 6-15-05

Pump Make Goulds Model WE07512HW Serial No.

Nitrification Field: No Fields 1 Square Feet 1260 Linear Feet 480

No Lines 6@70' Trench Width 36" Max Trench Bottom Depth 36" Gravel Depth NA

☑ New System ☐ Repair System Type: I, II, (III) IV, V, VI

System Description: PUMP OFFSITE 25% REDUCTION

Repair System Description: SAME

Maintenance Agreement Required: ☐ Yes ☑ No

☑ House/Mod. Home No. Bedrooms 4

☐ Mobile Home No. Bathrooms 4

☐ Business No. Employees

☐ Other


☐ Slab ☑ Crawl Space ☑ Basement w/plumbing ☐ Basement wo/plumbing

Water Supply: ☐ Individual ☐ Public ☑ Community

Comments:/Conditions: SEE ~~RED~~ COLOR CODED PLAT FOR SUPPLY LINE EASEMENT

Comments:/Conditions: Reviewed Building plans & Site plan 2/4/05; essentially in compliance with I.P. Checked lines & tanks 7/22/05 MD

INITIAL SITE SKETCH

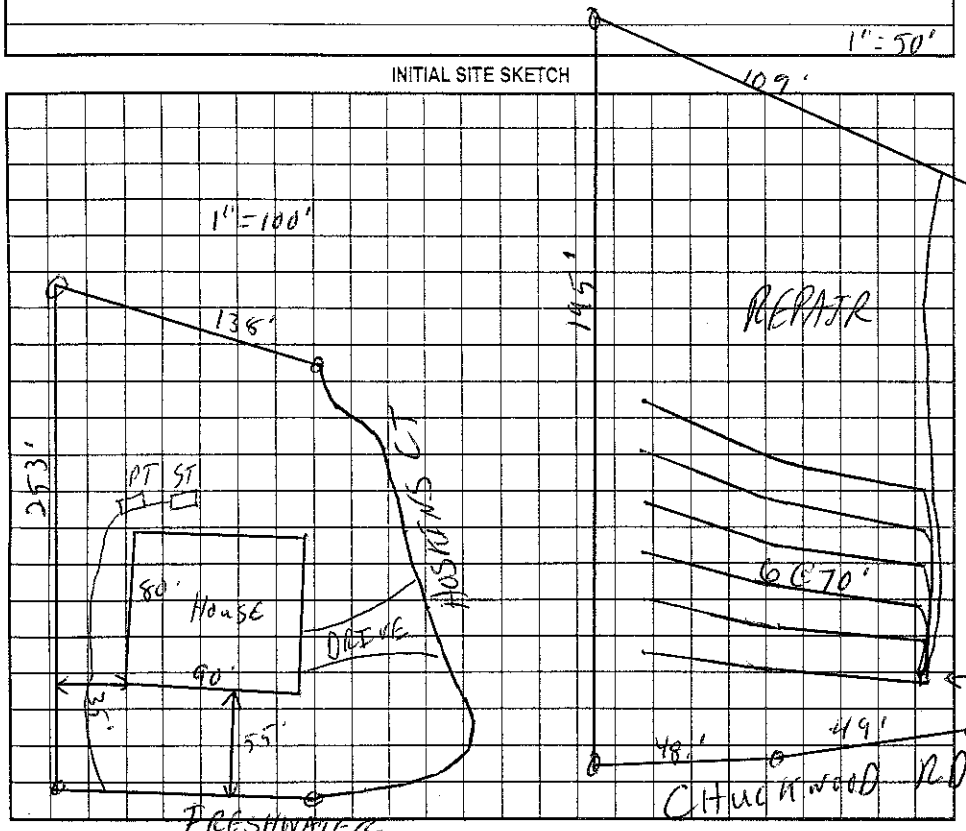

AS BUILT SKETCH

Installed EZ Flow as Drawn

Pressure, elect & alarm 8/4/05

Permit can be suspended or revoked if any false information is supplied toward securing the permit/any unauthorized changes are made to the site/any unauthorized changes are made in the installation of the system. Improvement Permit with plat valid without expiration. Improvement Permit with site plan valid for sixty months. Authorization to Construct is valid for a period equal to that of Improvement Permit – not to exceed sixty months.

Signed: [signature] date 8-25-03 Installed by: Bob Mayhew RS 8/4/05

Improvement Permit by: [signature] RS date 8/25/03 Operation Permit by: Maintained Dotson date

Authorization to Construct by: Maintained Dotson RS date 2/4/05 Existing System Inspection by: date

HEALTH DEPT. COPY: WHITE OWNER COPY (FINAL): YELLOW OWNER COPY (INITIAL): PINK