375

IREDELL COUNTY HEALTH DEPARTMENT

STATESVILLE 704-878-5305 MOORESVILLE 704-664-5281

IMPROVEMENT PERMIT / AUTHORIZATION TO CONSTRUCT / OPERATION PERMIT / EXISTING SYSTEM INSPECTION

PERMIT# 114296 PIN# ~~4626621968.258~~ 4626-61-9752 DATE 8/4/03

OWNER OR CONTRACTOR CRESCENT RESOURCES/L. Shaun Daden Const. PHONE: Business 660-1185 Home

ADDRESS 2214 BRAWLEY School - MOORESVILLE NC 28117

LOCATION BRAWLEY SCHOOL - TR SOUTHFORK - TL FRESHWATER - ON LT

SUBDIVISION THE FARMS BLOCK / SECTION 2 LOT 258 LOT AREA .97AC SITE CLASS. AS DESIGN FLOW 440GPD L.T.A.R. .36 PD/FT2

Septic Tank: 1000 Gallons; STB 338 Date 11-2-04
Pump Tank: 1400 Gallons; PT 37 Date 12-20-04
Pump Make: Goulds Model WE0312M Serial No.
Nitrification Field: No Fields 1 Square Feet 340 Linear Feet 270
No Lines 3@90' Trench Width 24" Max Trench Bottom Depth 36" Gravel Depth NA

☑ New System ☐ Repair System Type: I, II, III, (IV), V, VI
System Description: LP PANEL
Repair System Description: SAME
Maintenance Agreement Required: ☑ Yes ☐ No

☑ House/Mod. Home No. Bedrooms 4
☐ Mobile Home No. Bathrooms 4
☐ Business No. Employees
☐ Other


Water Supply: ☐ Individual ☐ Public ☑ Community

☐ Slab ☑ Crawl Space ☐ Basement w/plumbing ☐ Basement wo/plumbing


Comments:/Conditions: Reviewed Building plans 8/12/04, essentially in Compliance with IP

Comments:/Conditions:

INITIAL SITE SKETCH 1"=50'

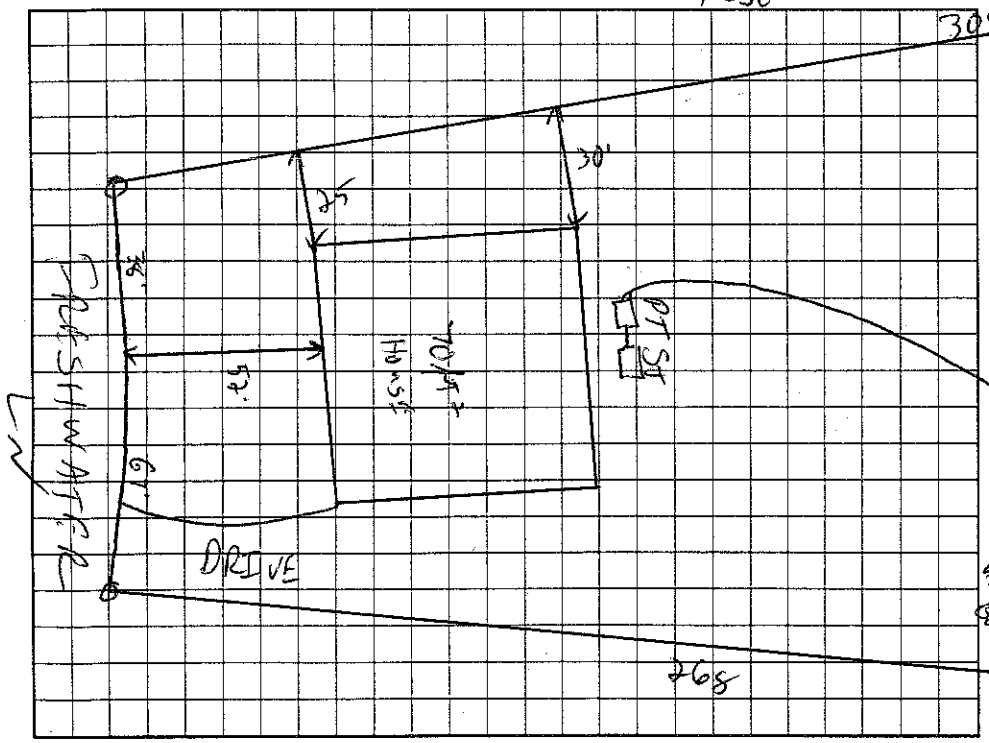

AS BUILT SKETCH

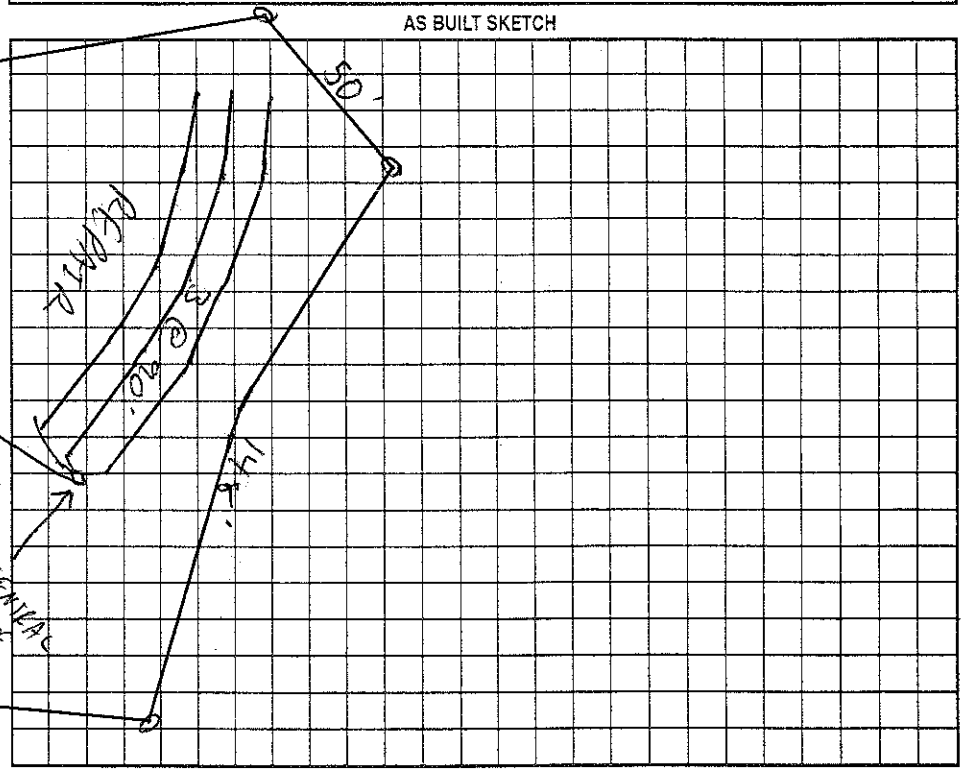

Permit can be suspended or revoked if any false information is supplied toward securing the permit/any unauthorized changes are made to the site/any unauthorized changes are made in the installation of the system. Improvement Permit with plat valid without expiration. Improvement Permit with site plan valid for sixty months. Authorization to Construct is valid for a period equal to that of Improvement Permit – not to exceed sixty months.

Signed: [signature] date 8-25-03 Installed by: Richard Hagenbuch RS

Improvement Permit by: [signature] RS date 8/4/03 Operation Permit by: Maria H. Dolan date 4/6/05

Authorization to Construct by: Maria H. Dolan RS date 8/12/04 Existing System Inspection by: date

HEALTH DEPT. COPY: WHITE OWNER COPY (FINAL): YELLOW OWNER COPY (INITIAL): PINK