IREDELL COUNTY HEALTH DEPARTMENT

STATESVILLE 704-878-5305 MOORESVILLE 704-664-5281

IMPROVEMENT PERMIT / AUTHORIZATION TO CONSTRUCT / OPERATION PERMIT / EXISTING SYSTEM INSPECTION

PERMIT# 144092 PIN# 4626621855.221

OWNER OR APPLICANT J.J. Testa DATE 8-23-07

ADDRESS 19901 W. Catawba Ave Suite 103 PHONE: Business 704-892-2995 Home

LOCATION Brawley School Rd TR Southfork TL Freshwater TR Ragsdale Trail TL Jack Pine Ct + end

SUBDIVISION The Farms BLOCK / SECTION 2 LOT 221 LOT AREA .82Ac SITE CLASS PS DESIGN FLOW 480gpd L.T.A.R. .3gpd/ft²

Septic Tank: ~~1000~~ + 500 Gallons; STB 338 Date 8/29/08

Pump Tank: 1000+ Gallons; PT 27 Date 6/22/08

Pump Make: Gould Model VED312 MU Serial No.

Nitrification Field: No Fields 1 Square Feet Linear Feet 270

No Lines 4 Trench Width 24" min. Max Trench Bottom Depth 36" Gravel Depth NA ☐ Gravity ☒ Pressure

☒ New System ☐ Repair ☐ Expansion System Type: I II III (IV) V VI

System Description: LP PPBPS

Repair System Description: LPPPBPS

Maintenance Agreement Required: ☒ Yes ☐ No

☒ House/Mod. Home ☐ Mobile Home ☐ Business ☐ Other

No. Bedrooms 4 No. Persons 8 No. Employees

Water Supply: ☐ Individual ☐ Public ☒ Community

☐ Slab ☒ Crawl Space ☐ Basement w/plumbing ☐ Basement wo/plumbing


Comments/Conditions: *Use specs according to crescent Community Manual
- Remove surface brush & debris before installation

Comments/Conditions: Expandle, 5/32" holes, 7.41 GPM


TRI COUNTY MAINTENANCE

1" = 60'

INITIAL SITE SKETCH

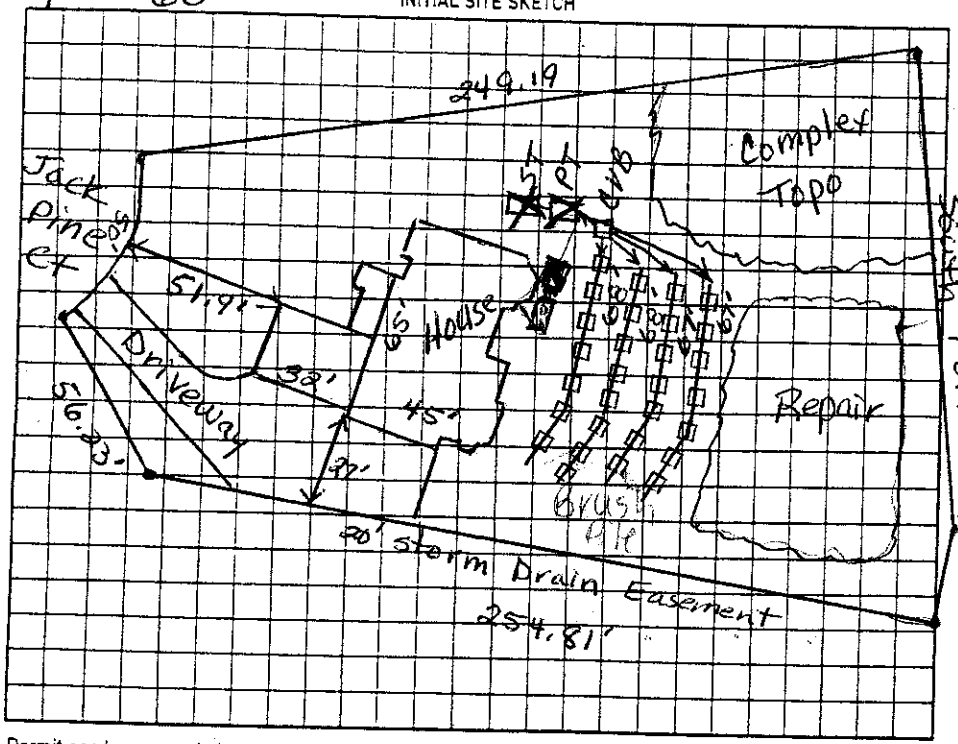

AS BUILT SKETCH

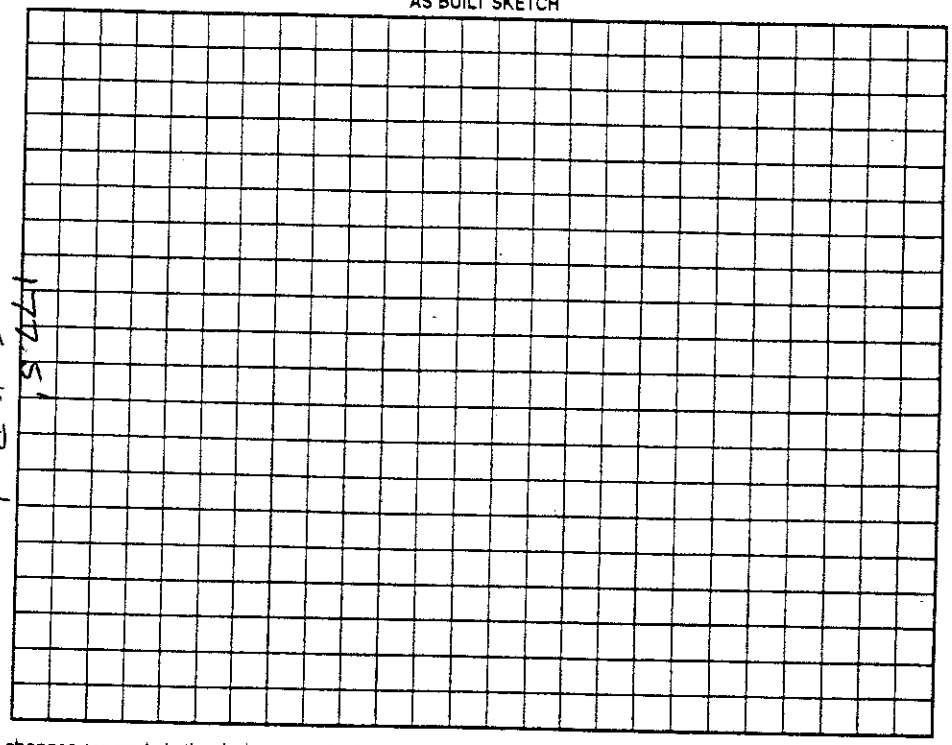

Permit can be suspended or revoked if any false information is supplied toward securing the permit/any unauthorized changes are made to the site/any unauthorized changes are made in the installation of the system. Improvement Permit with plat valid without expiration ☐ Improvement Permit with site plan valid for sixty months ☒ Authorization to Construct is valid for a period equal to that of Improvement Permit – not to exceed sixty months.

Signed: Jeffrey R Tutt date 8/28/07 Installed by: Stanley Septic Tanks

Improvement Permit by: Judy McNeill date 8-24-07 Operation Permit by: Wesley Sparks R.S. date 1/6/09

Authorization to Construct by: Judy McNeill date 8-24-07 Existing System Inspection by: date

HEALTH DEPT. COPY: WHITE OWNER COPY (FINAL): YELLOW OWNER COPY (INITIAL): PINK