IREDELL COUNTY HEALTH DEPARTMENT

STATESVILLE 704-878-5305 MOORESVILLE 704-664-5281

IMPROVEMENT PERMIT / AUTHORIZATION TO CONSTRUCT / OPERATION PERMIT / EXISTING SYSTEM INSPECTION

PERMIT # 144093 PIN # 4626621855.222 DATE 11/13/08

OWNER or APPLICANT Bob Hogan PHONE: Business 704-201-1922 Home: 704-799-1996

OWNER or APPLICANT ADDRESS 122 Oasis Lane 4626-62-2749

LOCATION / DIRECTIONS Brawley School, TR Southfork, TL Freshwater, TR Rossdale, TL Jack Pine, at end

SUBDIVISION The Farms BLOCK / SECTION 2 LOT # 222 LOT AREA 0.13Ac DESIGN FLOW 480 L.T.A.R. 0.3

Septic Tank ~~1000~~ 1500 Gallons: STB 338 Date 10-23-08

Pump Tank 1000 Gallons: PT 343 Date 10-6-08

Pump Make Gould Model WE3 1d MC Serial #

Nitrification Field No Fields 1 No Lines 6 Linear Feet 270

Trench Width 24" Max. Trench Bottom Depth 36" Gravel Depth NA

☒ New System ☐ Repair ☐ Expansion System Type I II III ☒ V VI

System Description: LP PPBPS

Repair System Description: LP PPBPS

Maintenance Agreement Required ☒ YES ☐ NO

☐ GRAVITY ☒ PRESSURE

☒ Residence No. Bedrooms 4

☐ Business No. Persons 8

☐ Other No. Employees

☐ Slab ☐ Crawl Space

☒ Basement w/plumbing ☐ Basement w/o plumbing

Water Supply: ☐ Private ☐ Public ☒ Community


Comments / Conditions * use specs according to Crescent community manual

- Drain pipe to be located within 2' of property line


* If gravity cannot be achieved from basement, grinder pump will be needed to left to upper floor

Comments / Conditions * Stay 15' away from basement side slope & 15' away from inground portion of pool

INITIAL SITE SKETCH

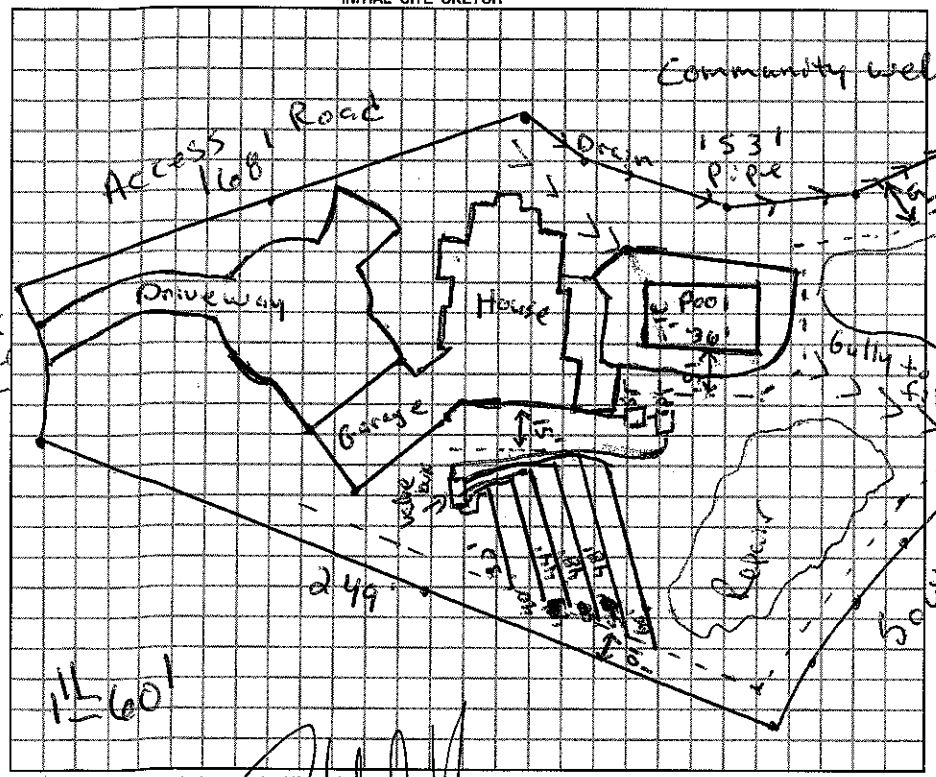

AS BUILT SKETCH

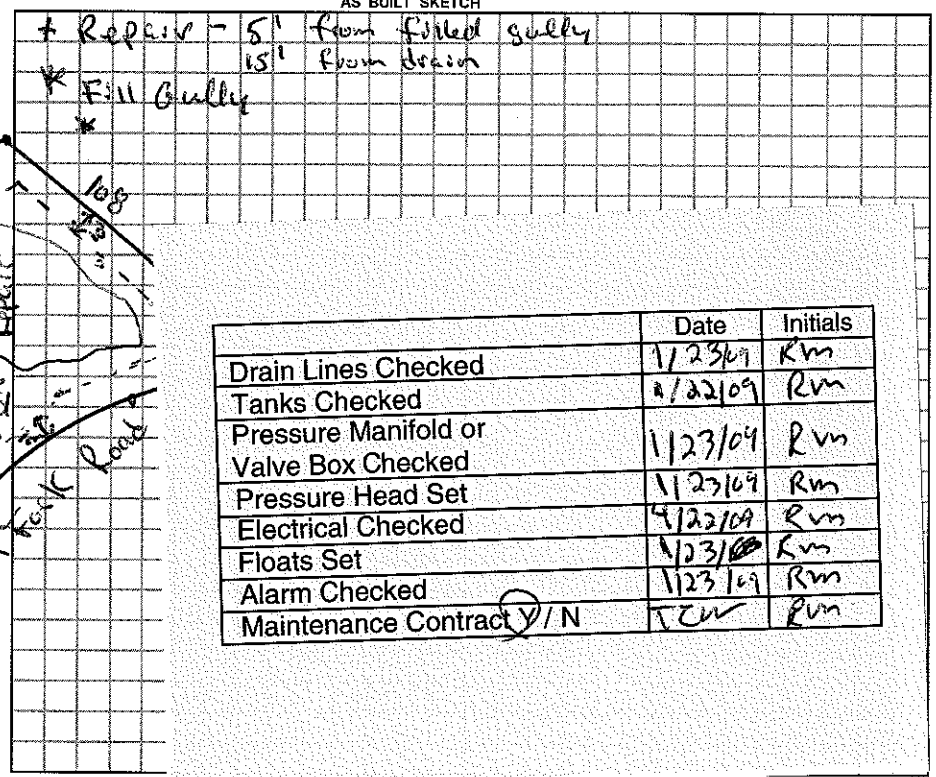

	Date	Initials
Drain Lines Checked	1/23/09	RM
Tanks Checked	1/22/09	RM
Pressure Manifold or Valve Box Checked	1/23/09	RM
Pressure Head Set	1/23/09	RM
Electrical Checked	4/22/09	RM
Floats Set	1/23/09	RM
Alarm Checked	1/23/09	RM
Maintenance Contract Y / N	TCW	RM

Permit can be suspended or revoked if any false information is supplied toward securing the permit / any unauthorized changes are made to the site / any unauthorized changes are made in the installation of the system.

☐ IMPROVEMENT PERMIT w / plat valid without expiration. ☒ IMPROVEMENT PERMIT w / site plan valid for 60 mos. ☒ AUTHORIZATION TO CONSTRUCT valid for period equal to IMPROVEMENT PERMIT-not to exceed 60 mo.

Owner / Applicant Signature: [signature] Date

Improvement Permit by: Ronnie Date 11/13/08

Authorization to Construct by: Ronnie Date 11/13/08

Installed by: Tarheel Septic

Operation Permit by: Ronnie Date: 4/22/09

Existing System Inspected by: Date:

YOU SHOULD CONTACT A LOCATOR SERVICE PRIOR TO ANY EXCAVATION.

WHITE COPY Environmental Health YELLOW COPY (Final) Owner / Applicant PINK COPY (Initial) Owner / Applicant