IREDELL COUNTY HEALTH DEPARTMENT

STATESVILLE 704-878-5305 MOORESVILLE 704-664-5281

IMPROVEMENT PERMIT / AUTHORIZATION TO CONSTRUCT / OPERATION PERMIT / EXISTING SYSTEM INSPECTION

PERMIT# 112522 PIN# 4626633715.229 4626-62-4683 DATE 8/7/03

OWNER OR CONTRACTOR CRESCENT RESOURCES / L. Shaun Ogden PHONE: Business 660-1185 Home

ADDRESS 2214 BRAWLEY SCHOOL - MOORESVILLE NC 28117

LOCATION BRAWLEY SCHOOL TR SOUTHFORK - TL FRESWATER - TR MCAULEY AT END

SUBDIVISION THE FARMS BLOCK / SECTION 2 LOT 229 LOT AREA .854C SITE CLASS PS DESIGN FLOW 480GPD L.T.A.R. .3680/KP

Septic Tank: 1000 Gallons; STB 5312 Date 8-24-04

Pump Tank: 1000 Gallons; PT 283 Date 9-6-04

Pump Make: Goulds Model WE10124C Serial No.

Nitrification Field: No Fields 1 Square Feet 1200 Linear Feet 400

No Lines 4 @ 100' Trench Width 36" Max Trench Bottom Depth 36" Gravel Depth N/A

☑ New System ☐ Repair System Type: I, II, (III) IV, V, VI

System Description: PUMP OFFSITE 35% REDUCTION

Repair System Description: SAME

Maintenance Agreement Required: ☐ Yes ☑ No

☑ House/Mod. Home ☐ Mobile Home ☐ Business ☐ Other

No. Bedrooms 4 No. Bathrooms 4 No. Employees


☐ Slab ☐ Crawl Space ☑ Basement w/plumbing ☐ Basement wo/plumbing

Water Supply: ☐ Individual ☐ Public ☑ Community


Comments:/Conditions:

Comments:/Conditions: Reviewed building plans & in compliance with original permit. Checked tanks & lines 10/13/04 MD. Checked pressure. 12/16/04 MS

INITIAL SITE SKETCH

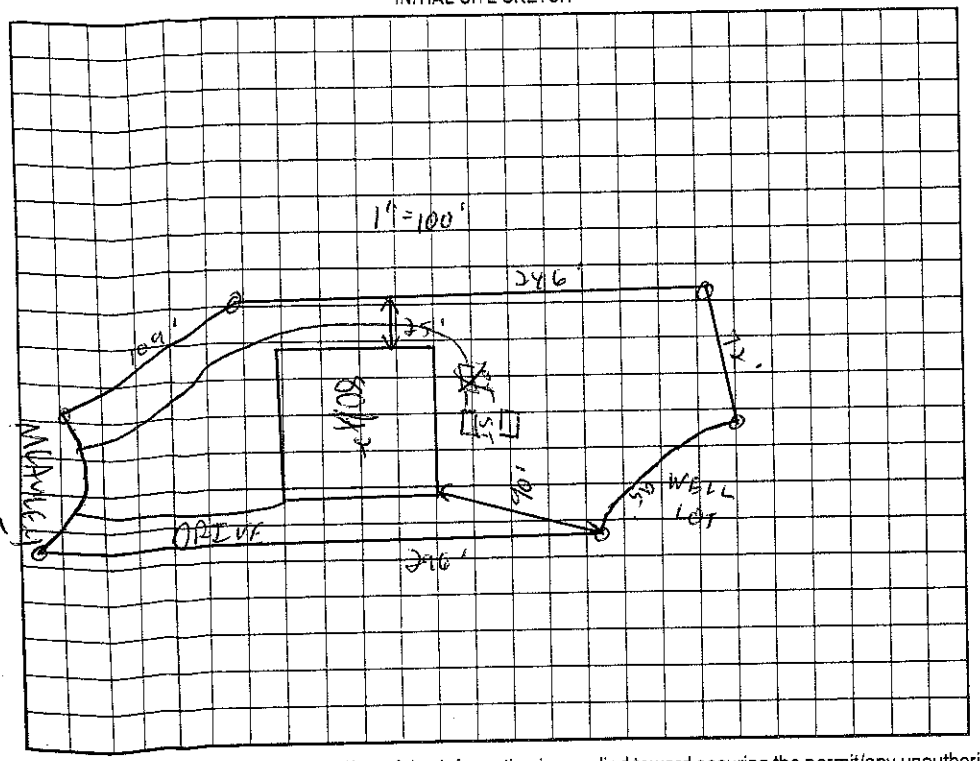

AS BUILT SKETCH

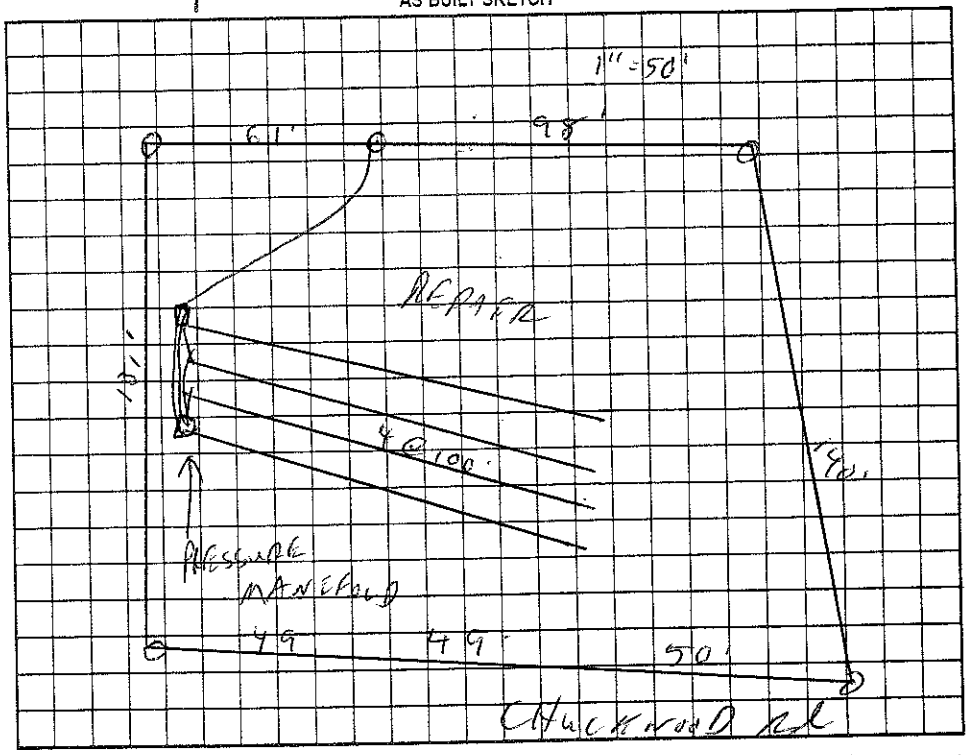

Permit can be suspended or revoked if any false information is supplied toward securing the permit/any unauthorized changes are made to the site/any unauthorized changes are made in the installation of the system. Improvement Permit with plat valid without expiration. Improvement Permit with site plan valid for sixty months. Authorization to Construct is valid for a period equal to that of Improvement Permit – not to exceed sixty months.

Signed: date 8-25-03 Installed by: Richard Abernathy

t Permit by: date 8/7/03 Operation Permit by: date 12/17/04

on to Construct by: date 3/17/04 Existing System Inspection by: date

HEALTH DEPT. COPY: WHITE OWNER COPY (FINAL): YELLOW OWNER COPY (INITIAL): PINK