IREDELL COUNTY HEALTH DEPARTMENT

STATESVILLE 704-878-5305 MOORESVILLE 704-664-5281

IMPROVEMENT PERMIT / AUTHORIZATION TO CONSTRUCT / OPERATION PERMIT / EXISTING SYSTEM INSPECTION

PERMIT# 112555 PIN# ~~4626637315.235~~ 4626625153 DATE 8/11/03

OWNER OR CONTRACTOR CRESCENT RESOURCES / Courtland Properties PHONE: Business 660-1185 Home

ADDRESS 2214 BRAWLEY SCHOOL - MOORESVILLE NC 28117

LOCATION BRAWLEY SCHOOL - IR SOUTHFORK - TL FRESHWATER IR HOUSINS - AT END

SUBDIVISION TITH FARMS BLOCK / SECTION 2 LOT 235 LOT AREA 1.76AC SITE CLASS. PS DESIGN FLOW 450GPD L.T.A.R. .25000/FT2

Septic Tank: 1500 Gallons; STB 338 Date 5/30/05

Pump Tank: 1500 Gallons; PT 47 Date 1/10/05

Pump Make: GOULDS Model WE 1512 Serial No.

Nitrification Field: No Fields 1 Square Feet 1440 Linear Feet 480

No Lines 6@80' Trench Width 36" Max Trench Bottom Depth 36" Gravel Depth N/A

☑ New System ☐ Repair System Type: I, II, III, IV, V, VI

System Description: PUMP OFFSITE 25% REDUCTION

Repair System Description: LP PANEL

Maintenance Agreement Required: ☐ Yes ☑ No

☑ House/Mod. Home ☐ Mobile Home ☐ Business ☐ Other

No. Bedrooms 4 No. Bathrooms 4 No. Employees


Water Supply: ☐ Individual ☐ Public ☒ Community

☐ Slab ☐ Crawl Space ☑ Basement w/plumbing ☐ Basement wo/plumbing


Comments:/Conditions: Reviewed Building plans, essentially in Compliance with orighal Improvement Permit Note: Drive on other side.

Comments:/Conditions: EZ Flow installed

INITIAL SITE SKETCH

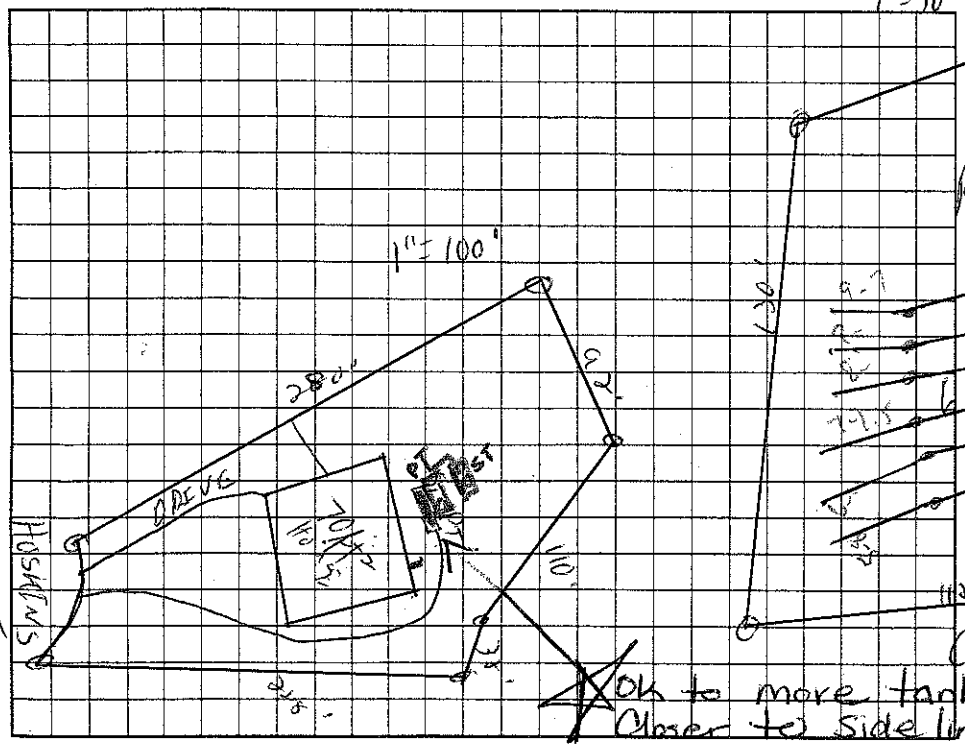

AS BUILT SKETCH

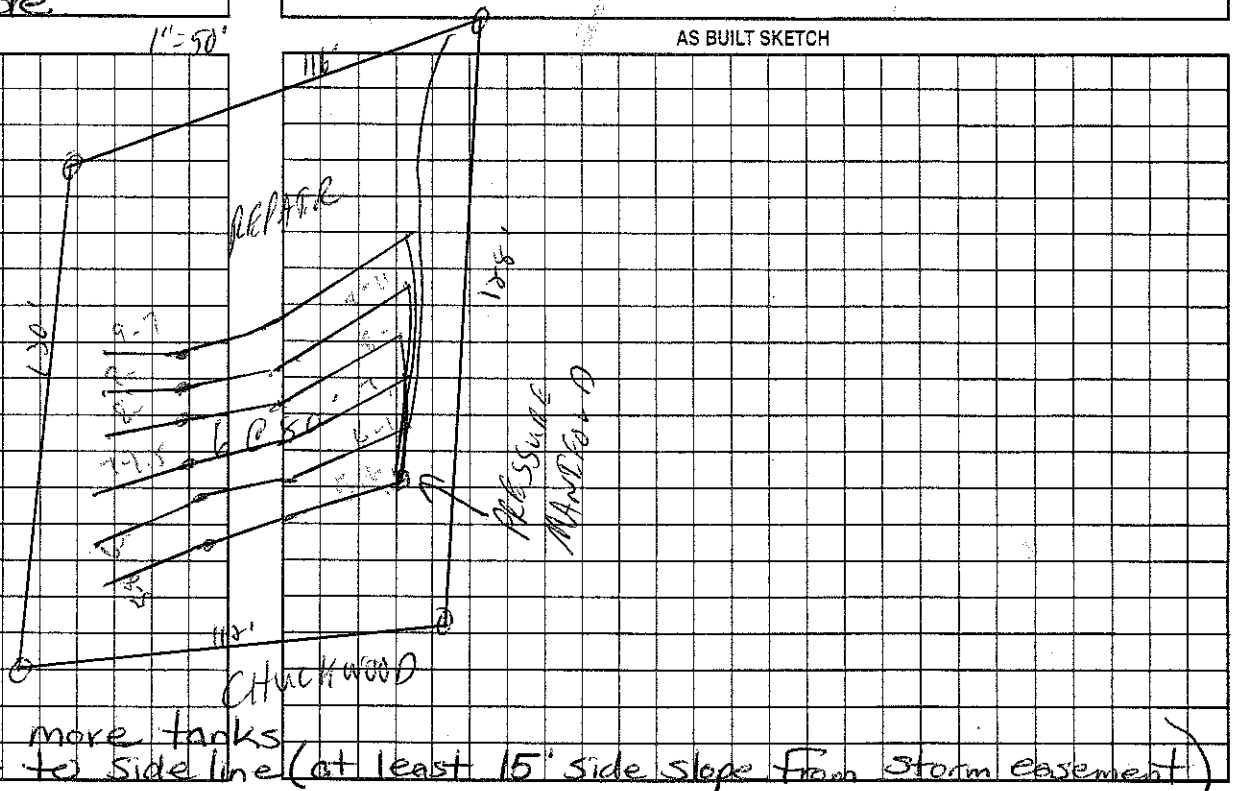

Ok to move tanks Closer to side line (at least 15' side slope from storm easement)

Permit can be suspended or revoked if any false information is supplied toward securing the permit/any unauthorized changes are made to the site/any unauthorized changes are made in the installation of the system. Improvement Permit with plat valid without expiration. Improvement Permit with site plan valid for sixty months. Authorization to Construct is valid for a period equal to that of Improvement Permit -- not to exceed sixty months.

Signed: _____ date 8-23-03 Installed by: Stanley Septic Service

Improvement Permit by: _____ RS date 8/11/03 Operation Permit by: Wesley Sparks RS date 7/18/05

Authorization to Construct by: _____ RS date 2/1/05 Existing System Inspection by: _____ date _____

HEALTH DEPT. COPY: WHITE OWNER COPY (FINAL): YELLOW OWNER COPY (INITIAL): PINK