Ows 130

IREDELL COUNTY HEALTH DEPARTMENT

STATESVILLE 704-878-5305 MOORESVILLE 704-664-5281

IMPROVEMENT PERMIT / AUTHORIZATION TO CONSTRUCT / OPERATION PERMIT / EXISTING SYSTEM INSPECTION

PERMIT# 112552 PIN# 4626637315.232 4026627328 DATE 9/22/03

OWNER OR CONTRACTOR ~~CBS~~ CRESCENT RESOURCES/ES JOHNSON PHONE: Business 660-1185 Home

ADDRESS 2214 BRAWLEY SCHOOL - MOORESVILLE NC 28117

LOCATION BRAWLEY SCHOOL - TR SOUTHFORK - TL FRESHWATER - TR MCAULEY CT - ON LT CORNER

SUBDIVISION THE FARMS BLOCK / SECTION 2 LOT 232 LOT AREA .80AC SITE CLASS. A5 DESIGN FLOW 480GPD L.T.A.R. .300/1.0

Septic Tank: 1000 Gallons; STB 338 Date 11/25/04

Pump Tank: 1000 Gallons; PT 283 Date 11/16/05

Pump Make: Myers Model ME75 Serial No.

Nitrification Field: No Fields 1 Square Feet 1200 Linear Feet 400

No Lines 5 @ 80' Trench Width 36" Max Trench Bottom Depth 36" Gravel Depth n/a

☑ New System ☐ Repair System Type: I, II, III, IV, V, VI

System Description: PUMP OFFSITE 25% REDUCTION

Repair System Description: SAME OFFSITE

Maintenance Agreement Required: ☐ Yes ☑ No

☑ House/Mod. Home No. Bedrooms 4

☐ Mobile Home No. Bathrooms 4

☐ Business No. Employees

☐ Other


☐ Slab ☐ Crawl Space ☑ Basement w/plumbing ☐ Basement wo/plumbing

Water Supply: ☐ Individual ☐ Public ☑ Community


Comments:/Conditions: SEE COLOR CODED PLAN FOR PUMP SUPPLY LINE EASEMENT.

Comments:/Conditions:

INITIAL SITE SKETCH

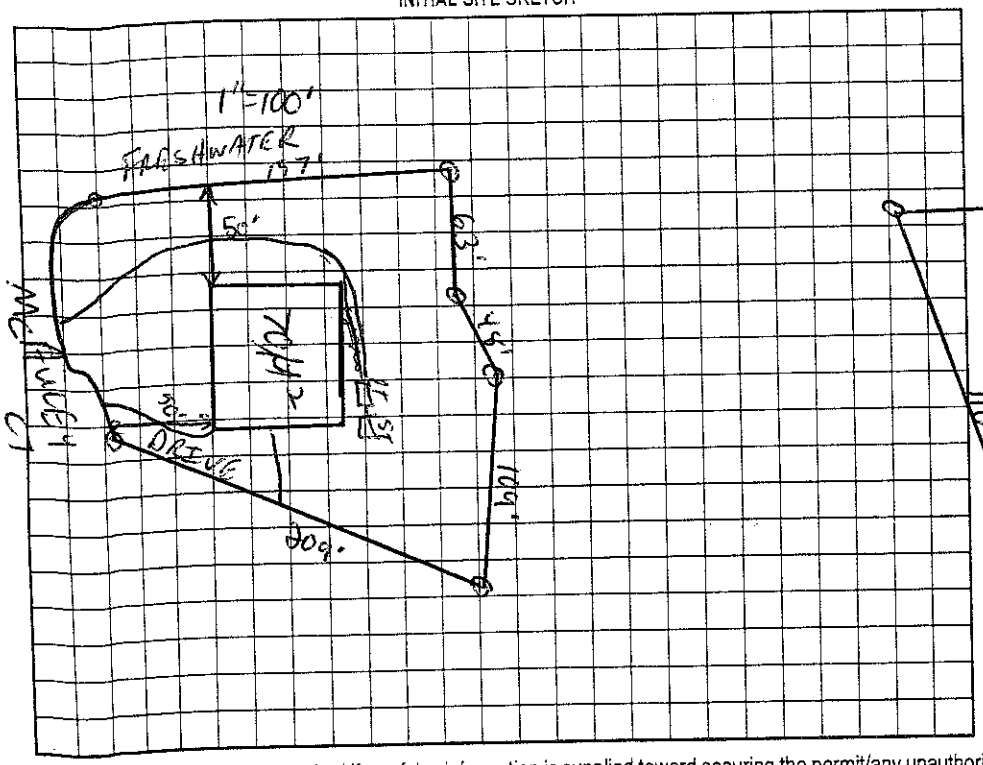

AS BUILT SKETCH

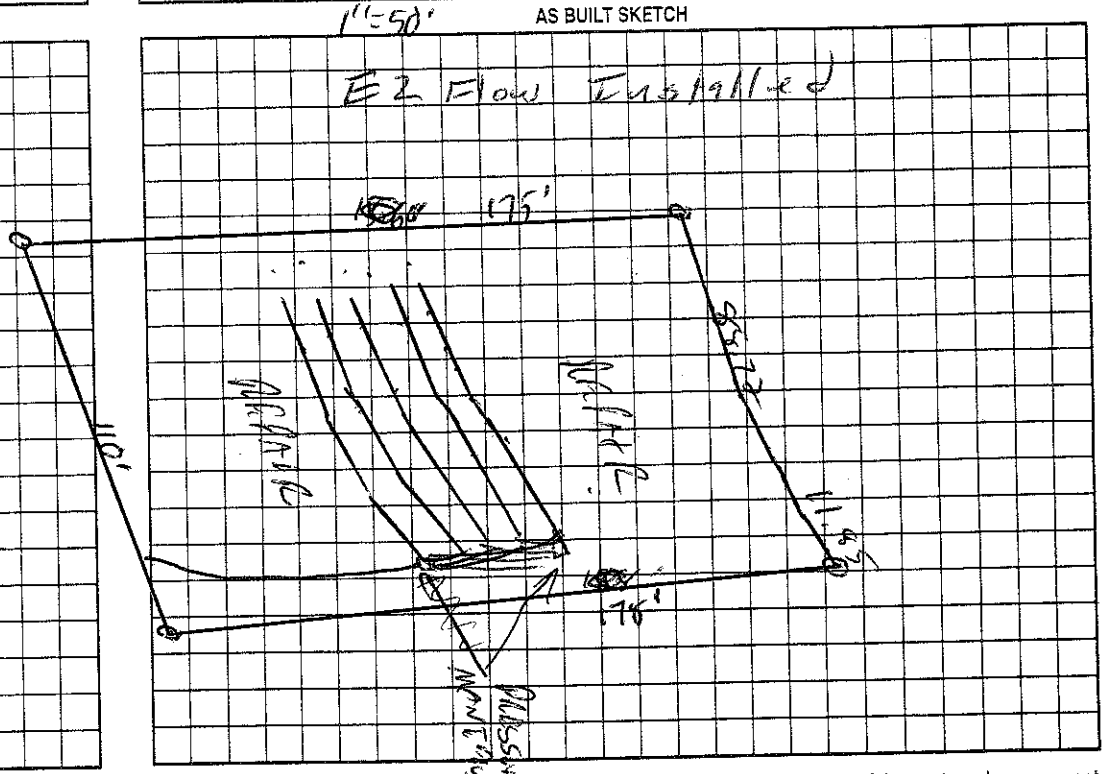

Permit can be suspended or revoked if any false information is supplied toward securing the permit/any unauthorized changes are made to the site/any unauthorized changes are made in the installation of the system. Improvement Permit with plat valid without expiration. Improvement Permit with site plan valid for sixty months. Authorization to Construct is valid for a period equal to that of Improvement Permit – not to exceed sixty months.

Signed: date 9-25-03 Installed by: Christen Long RS date 5/12/05

Improvement Permit by: C. Ross RS date 9/30/03 Operation Permit by: Maria H. Dotson RS date

Authorization to Construct by: Wesley Parks RS date 4/18/04 Existing System Inspection by: date

HEALTH DEPT. COPY: WHITE OWNER COPY (FINAL): YELLOW OWNER COPY (INITIAL): PINK