IREDELL COUNTY HEALTH DEPARTMENT

STATESVILLE 704-878-5305 MOORESVILLE 704-664-5281

IMPROVEMENT PERMIT / AUTHORIZATION TO CONSTRUCT / OPERATION PERMIT / EXISTING SYSTEM INSPECTION

375 4100

PERMIT# 112584 PIN# ~~4626-73-7315.264~~ 4626-62-9957 DATE 8/12/03

OWNER OR CONTRACTOR CRESCENT RESOURCES / ES JOHNSON CO. PHONE: Business 660-1185 Home

ADDRESS 2214 BRAWLEY SCHOOL - MOORESVILLE NC 28117

LOCATION BRAWLEY SCHOOL - TR SOUTH FORK - TL FRESHWATER ON LT (TL Brawley) Lee Acres

SUBDIVISION THE FARMS BLOCK / SECTION 2 LOT 264 LOT AREA .784 C SITE CLASS. PS DESIGN FLOW ~~440 GAD~~ L.T.A.R. ~~.784~~ 440 GPD

Septic Tank: ~~1000~~ 1500 Gallons; STB 328 Date 9-20-05

Pump Tank: ~~1000~~ 1500 Gallons; PT 297 Date 9-14-05

Pump Make: Myers Model ME100 Serial No.

Nitrification Field: No. Fields 1 Square Feet 840 ~~800~~ Linear Feet 840

No Lines 6 @ 70' Trench Width 24" Max Trench Bottom Depth 36" Gravel Depth N/A

☑ New System ☐ Repair System Type: I, II, III, IV, V, VI

System Description: LP PANEL OFFSITE

Repair System Description: SAME

Maintenance Agreement Required: ☑ Yes ☐ No

☑ House/Mod. Home No. Bedrooms ~~4~~ 5

☐ Mobile Home No. Bathrooms 4

☐ Business No. Employees

☐ Other


☐ Slab ☑ Crawl Space ☐ Basement w/plumbing ☐ Basement wo/plumbing

Water Supply: ☐ Individual ☐ Public ☑ Community

Comments:/Conditions:

Comments:/Conditions: 16 panels per drtan
Checked tanks & lines 10/27/05
Pressure checked 1/11/06 Elect & Alarm

INITIAL SITE SKETCH 1" = 10'

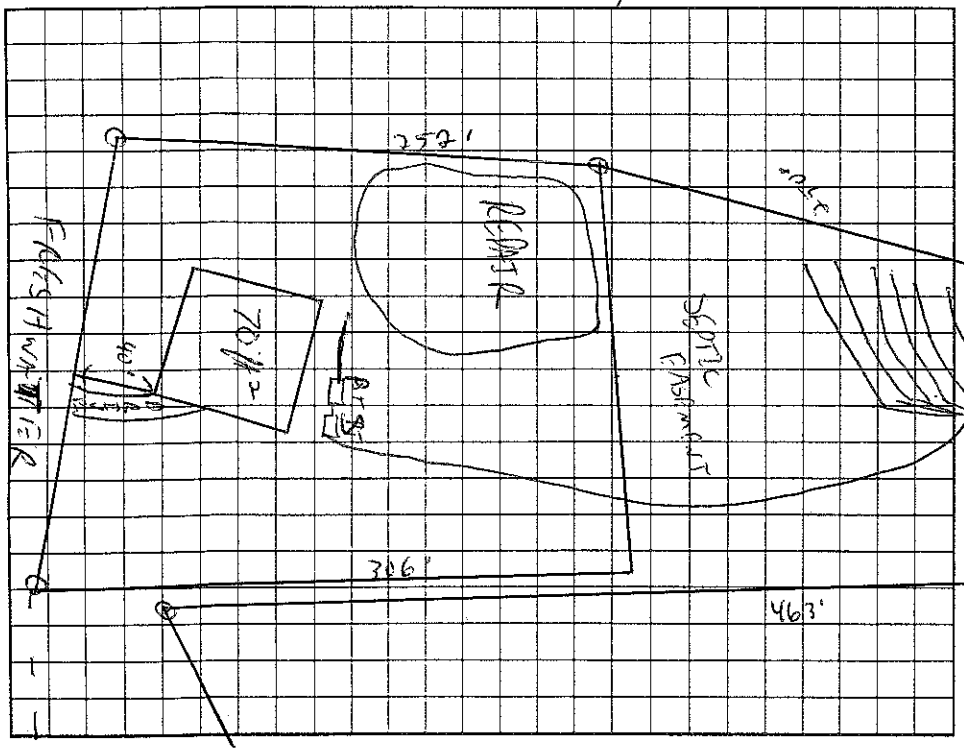

AS BUILT SKETCH

Installed essentially as Drawn

Permit can be suspended or revoked if any false information is supplied toward securing the permit/any unauthorized changes are made to the site/any unauthorized changes are made in the installation of the system. Improvement Permit with plat valid without expiration. Improvement Permit with site plan valid for sixty months. Authorization to Construct is valid for a period equal to that of Improvement Permit – not to exceed sixty months.

Signed: _____ date 8-25-03 Installed by: Willie Christenbury RS

Improvement Permit by: C. [illegible] RS date 8/12/03 Operation Permit by: [illegible] RS date 1/11/06

Authorization to Construct by: Willie Sparks RS. date 6/9/05 Existing System Inspection by: _____ date _____

HEALTH DEPT. COPY: WHITE OWNER COPY (FINAL): YELLOW OWNER COPY (INITIAL): PINK