375 300

IREDELL COUNTY HEALTH DEPARTMENT

STATESVILLE 704-878-5305 MOORESVILLE 704-664-5281

IMPROVEMENT PERMIT / AUTHORIZATION TO CONSTRUCT / OPERATION PERMIT / EXISTING SYSTEM INSPECTION

PERMIT# 112447 PIN# ~~4626637315~~ 206 4626-63-1482 DATE 7/29/03

OWNER OR CONTRACTOR CRESCENT RESOURCES/HUGHES & ASSOC. INC. PHONE: Business 660-1185 Home

ADDRESS 214 BRAWLEY SCHOOL - MOORESVILLE NC 28117

LOCATION BRAWLEY SCHOOL - TR SOUTHFORK - TL FRESHWATER - TR RAVENSDALE - ON RT

SUBDIVISION THE FARMS BLOCK / SECTION 2 LOT 206 LOT AREA .71AC SITE CLASS RS DESIGN FLOW 480GPD L.T.A.R. ~~.36~~ .25GPD/FT2

Septic Tank: 1000 Gallons; STB 338 Date 4-2-05
Pump Tank: 1000 Gallons; PT 27 Date 3-28-05
Pump Make: Model Serial No.
Nitrification Field: No Fields 1 Square Feet 640 Linear Feet 320
No Lines 4@80' Trench Width 24" Max Trench Bottom Depth 36" Gravel Depth N/A

☑ New System ☐ Repair System Type: I, II, III, (IV), V, VI
System Description: LP PANEL
Repair System Description: SAME
Maintenance Agreement Required: ☑ Yes ☐ No


☑ House/Mod. Home No. Bedrooms 4
☐ Mobile Home No. Bathrooms 4
☐ Business No. Employees
☐ Other
☐ Slab ☑ Crawl Space ☐ Basement w/plumbing ☐ Basement wo/plumbing

Water Supply:
☐ Individual
☐ Public
☑ Community

Comments/Conditions:

Comments/Conditions: 5/4/05 Checked 3 of 4 lines & tanks
Checked 4th line 5/5/05

INITIAL SITE SKETCH 1"=50'

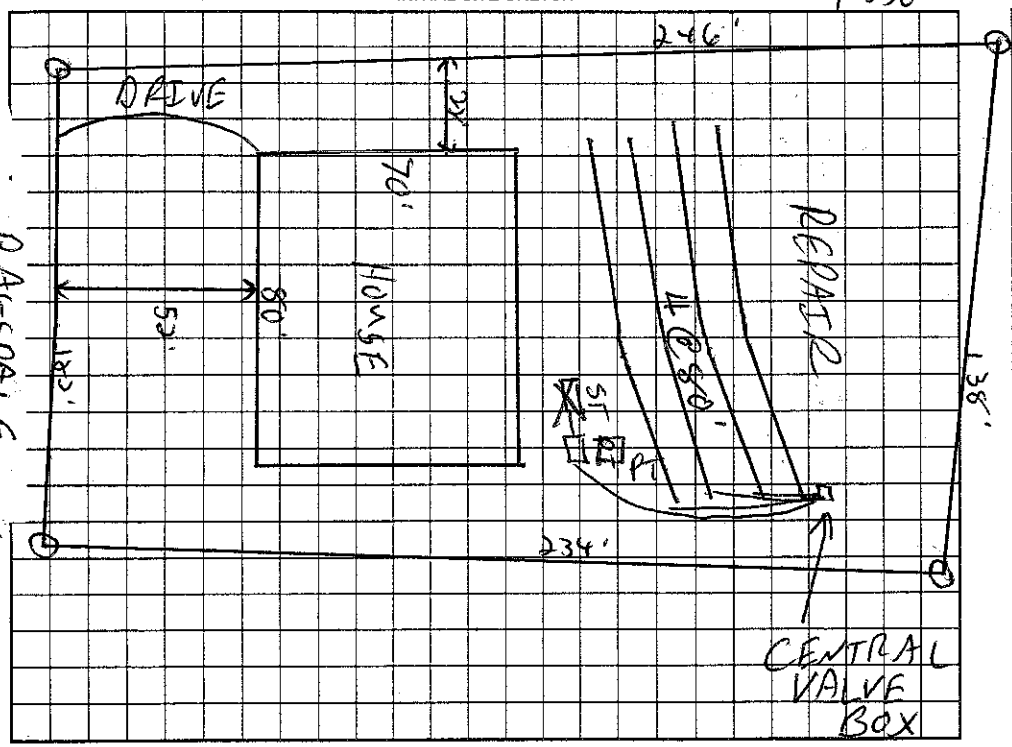

AS BUILT SKETCH

Permit can be suspended or revoked if any false information is supplied toward securing the permit/any unauthorized changes are made to the site/any unauthorized changes are made in the installation of the system. Improvement Permit with plat valid without expiration. Improvement Permit with site plan valid for sixty months. Authorization to Construct is valid for a period equal to that of Improvement Permit – not to exceed sixty months.

Signed: date 8-7-03 Installed by: R&H

Improvement Permit by: RS date 7/29/03 Operation Permit by: Wesley Sparks RS date 7/29/05

Authorization to Construct by: RS date 10/19/04 Existing System Inspection by: date

HEALTH DEPT. COPY: WHITE OWNER COPY (FINAL): YELLOW OWNER COPY (INITIAL): PINK