IREDELL COUNTY HEALTH DEPARTMENT

STATESVILLE 704-878-5305 MOORESVILLE 704-664-5281

IMPROVEMENT PERMIT / AUTHORIZATION TO CONSTRUCT / OPERATION PERMIT / EXISTING SYSTEM INSPECTION

PERMIT # 160574 PIN # 4626663100 DATE 4-16-2010

OWNER or APPLICANT Glenna Sarah Roman PHONE: Business 704 929-9976 Home: 704 660-5500

OWNER or APPLICANT ADDRESS 123 Ragsdale Trail Mooresville NC 28117

LOCATION / DIRECTIONS Brawley School Rd TR SouthFork TL Freshwater TR Ragsdale on left on Corner of Jack Pine

SUBDIVISION The Farms BLOCK / SECTION LOT # 224 LOT AREA 1.12Ac. DESIGN FLOW 480gpd L.T.A.R. .3

Septic Tank 1500 Gallons: STB Date

Pump Tank 1500 Gallons: PT Date

Pump Make Model Serial #

Nitrification Field No Fields 1 No Lines 4 Linear Feet 300

Trench Width 36" Max. Trench Bottom Depth Gravel Depth

☐ New System ☐ Repair ☐ Expansion System Type I II III (IV) V VI

System Description: Existing Pump-LP Panel Blk

Repair System Description: Same

Maintenance Agreement Required ☒ YES ☐ NO

☐ GRAVITY ☒ PRESSURE

☒ Residence No. Bedrooms 4

☐ Business No. Persons

☐ Other No. Employees

☐ Slab ☐ Crawl Space


☐ Basement w/plumbing ☐ Basement w/o plumbing

Water Supply: ☐ Private ☐ Public ☒ Community


Comments / Conditions: Existing Septic System Appears to be Functioning okay.

Comments / Conditions: Must keep footers of deck at least 5ft From ST & PT

INITIAL SITE SKETCH

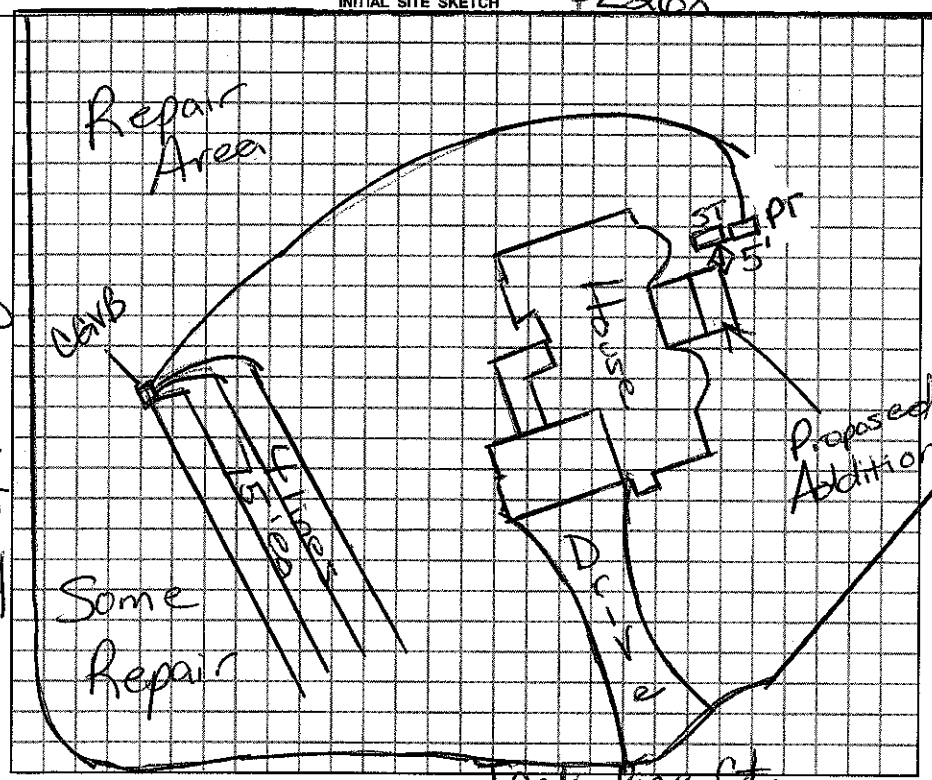

AS BUILT SKETCH

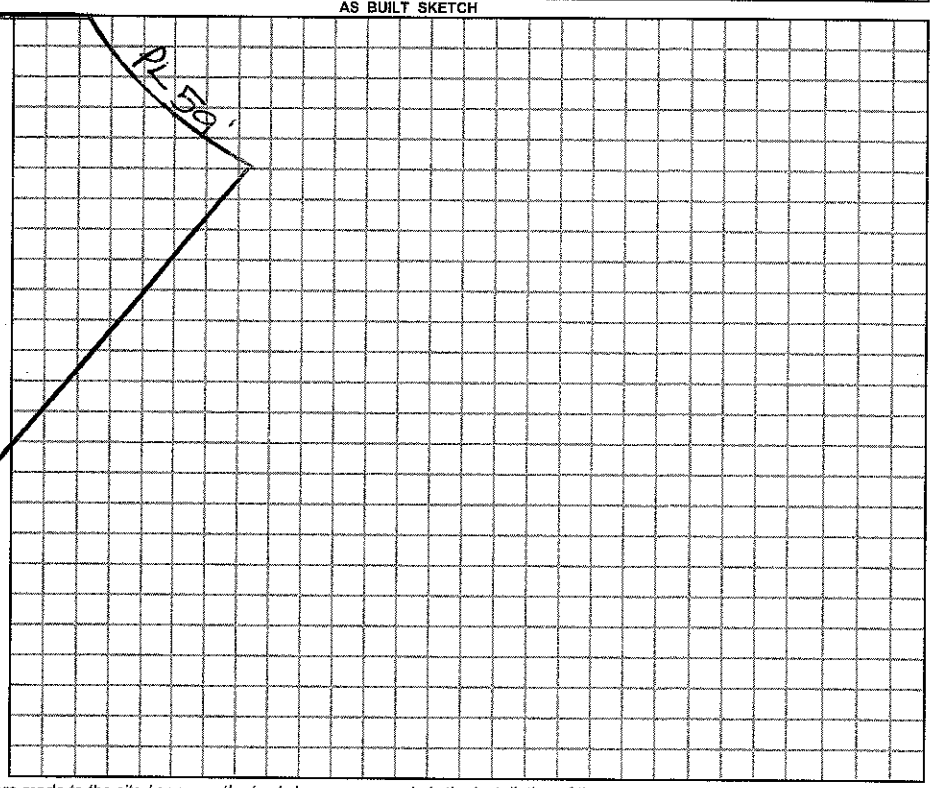

Permit can be suspended or revoked if any false information is supplied toward securing the permit / any unauthorized changes are made to the site / any unauthorized changes are made in the installation of the system.

☐ *IMPROVEMENT PERMIT w / plat valid without expiration.* ☐ *IMPROVEMENT PERMIT w / site plan valid for 60 mos.* ☐ *AUTHORIZATION TO CONSTRUCT valid for period equal to IMPROVEMENT PERMIT-not to exceed 60 mo.*

Owner / Applicant Signature: Sarah Roman Date 4/19/2010

Improvement Permit by: Date

Authorization to Construct by: Date

Installed by: Curt Dunning

Operation Permit by: Date:

Existing System Inspected by: Marian H Dolan RS Date: 4/16/2010

YOU SHOULD CONTACT A LOCATOR SERVICE PRIOR TO ANY EXCAVATION.

WHITE COPY Environmental Health YELLOW COPY (Final) Owner / Applicant PINK COPY (Initial) Owner / Applicant