375

IREDELL COUNTY HEALTH DEPARTMENT

STATESVILLE 704-878-5305 MOORESVILLE 704-664-5281

IMPROVEMENT PERMIT / AUTHORIZATION TO CONSTRUCT / OPERATION PERMIT / EXISTING SYSTEM INSPECTION

PERMIT# 112508 PIN# ~~4626.63.7315.224~~ 4626-63-3100 DATE 7/31/03

OWNER OR CONTRACTOR CRESCENT RESOURCES / Whitley Co. PHONE: Business 660-1185 Home

ADDRESS 2214 BRAWLEY SCHOOL - MOORESVILLE NC 28117

LOCATION BRAWLEY SCHOOL - TR SOUTHFORK - TL FRESHWATER - TR RAG-DALE - TR ~~BRAY-TOM~~ - ON LT CORNER

SUBDIVISION THE FARMS BLOCK / SECTION 2 LOT 224 LOT AREA 1.12AC SITE CLASS PS DESIGN FLOW 480GAD L.T.A.R. ~ 3600/FT²

JACK PINE CT.

Septic Tank: 1500 Gallons; STB 338 Date 3/20/05

Pump Tank: 1000 Gallons; PT 283 Date 11/3/04

Pump Make: Model Serial No.

Nitrification Field: No Fields 1 Square Feet 600 Linear Feet 300

No Lines 6@50' Trench Width 24" Max Trench Bottom Depth 36" Gravel Depth N/A

☑ New System ☐ Repair System Type: I, II, III, (IV), V, VI

System Description: LP PANEL

Repair System Description: SAME

Maintenance Agreement Required: ☑ Yes ☐ No

☑ House/Mod. Home No. Bedrooms 4

☐ Mobile Home No. Bathrooms 4

☐ Business No. Employees

☐ Other


☐ Slab ☑ Crawl Space ☐ Basement w/plumbing ☐ Basement wo/plumbing

Water Supply: ☐ Individual ☐ Public ☑ ~~Community~~


Comments:/Conditions: 5/2/05 Authorized change to 4@75' per Board
PPBPS lines in location shown! Apps-50'

Comments:/Conditions: Reviewed Building plans & site plan, essentially in compliance with original permit

INITIAL SITE SKETCH

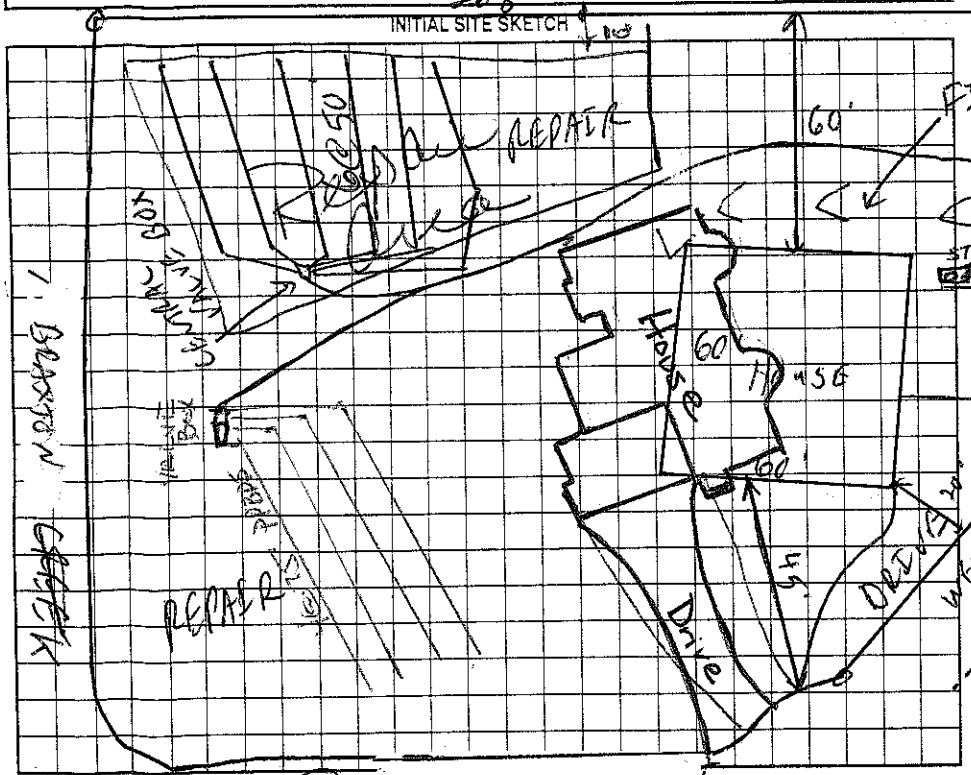

AS BUILT SKETCH

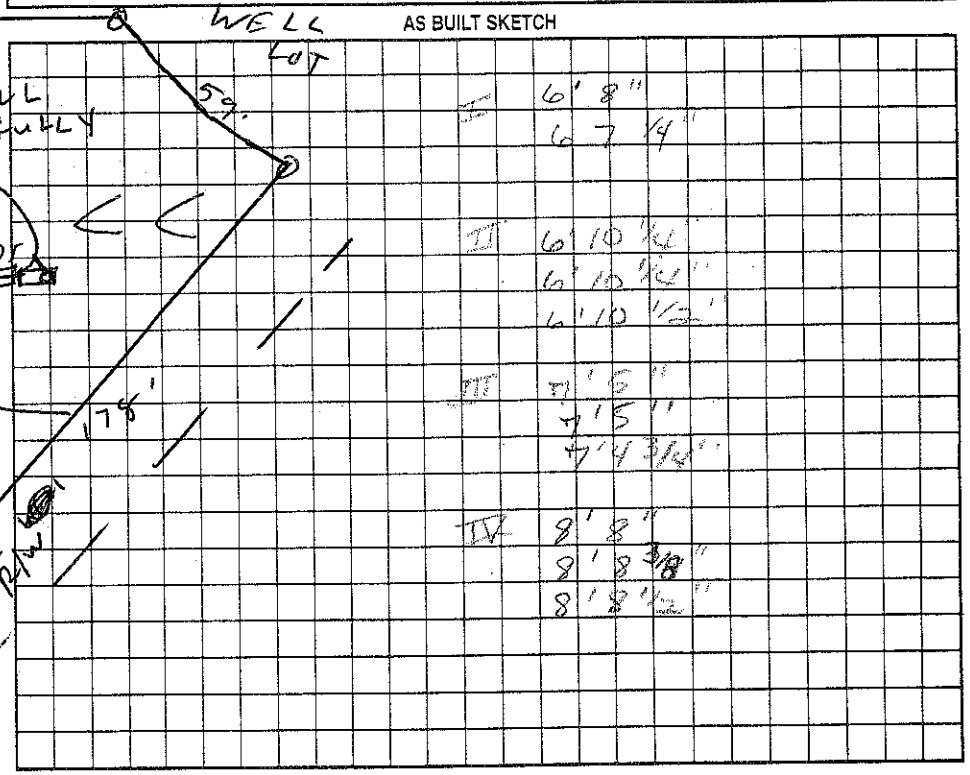

Permit can be suspended or revoked if any false information is supplied toward securing the permit/any unauthorized changes are made to the site/any unauthorized changes are made in the installation of the system. Improvement Permit with plat valid without expiration. Improvement Permit with site plan valid for sixty months. Authorization to Construct is valid for a period equal to that of Improvement Permit – not to exceed sixty months.

Signed: date Installed by: Cent Dunnagan

Improvement Permit by: RS date 7/31/03 Operation Permit by: Wesley Sparks RS. date 5/6/05

Authorization to Construct by: RS date 5/31/04 Existing System Inspection by: date

HEALTH DEPT. COPY: WHITE OWNER COPY (FINAL): YELLOW OWNER COPY (INITIAL): PINK