IREDELL COUNTY HEALTH DEPARTMENT

STATESVILLE 704-878-5305 MOORESVILLE 704-664-5281

IMPROVEMENT PERMIT / AUTHORIZATION TO CONSTRUCT / OPERATION PERMIT / EXISTING SYSTEM INSPECTI

PERMIT# 112445 PIN# 4626637315.205 4626633319 DATE 7/29/03

OWNER OR CONTRACTOR CRESCENT RESOURCES / Shawn Ogden PHONE: Business 660-1185 Home

ADDRESS 2214 BRAWLEY SCHOOL - MOORESVILLE NC 28117

LOCATION BRAWLEY SCHOOL - TR SOUTH FORK - TL FRESHWATER - TR . RAGSDALE - ON RT

SUBDIVISION THE FARMS BLOCK / SECTION 2 LOT 205 LOT AREA .714C SITE CLASS PS DESIGN FLOW 480GPD L.T.A.R. .36PD/FT2

Septic Tank: 1000 Gallons; STB 338 Date 8-2-05

Pump Tank: Gallons; PT Date

Pump Make: Model Serial No.

Nitrification Field: No Fields 1 Square Feet 1200 Linear Feet 400

No Lines 4@100' Trench Width 36" Max Trench Bottom Depth 36" Gravel Depth N/A

☑ New System ☐ Repair System Type: I, II, III, IV, V, VI

System Description: GRAVITY 25% REDUCTION

Repair System Description: LP PANEL

Maintenance Agreement Required: ☐ Yes ☑ No

☑ House/Mod. Home No. Bedrooms 4

☐ Mobile Home No. Bathrooms 4

☐ Business No. Employees

☐ Other


☐ Slab ☑ Crawl Space ☐ Basement w/plumbing ☐ Basement wo/plumbing

Water Supply: ☐ Individual ☐ Public ☑ Community

Comments:/Conditions: Reviewed Building plans 4/12/05; in Compliance with original permit

Comments:/Conditions: Gravity - Quick 4

INITIAL SITE SKETCH 1" = 50'

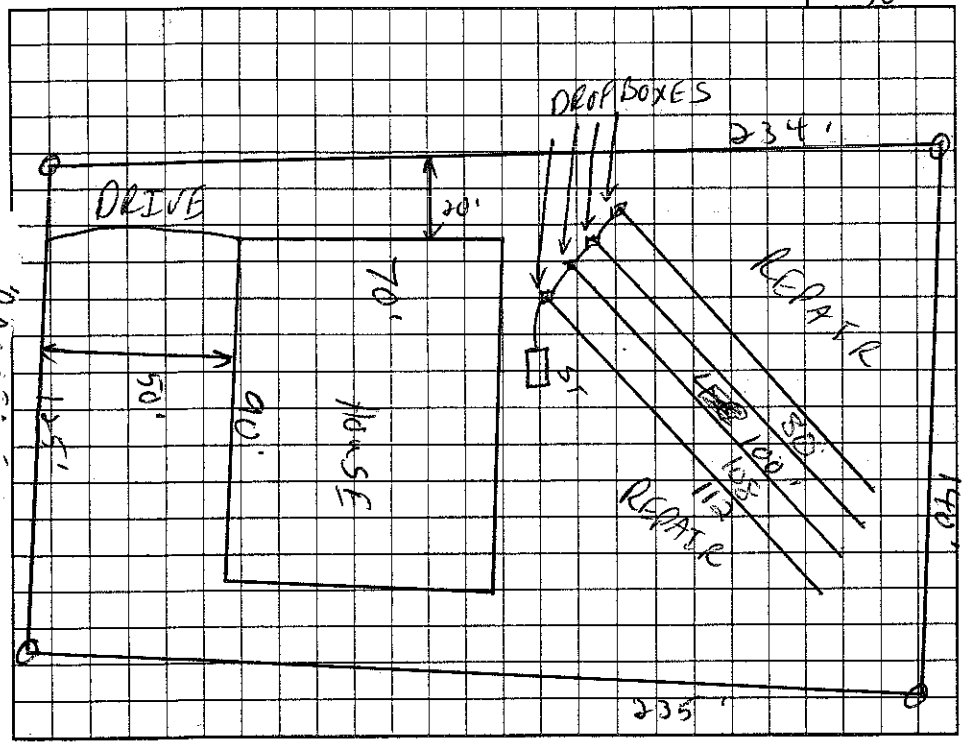

AS BUILT SKETCH

Installed essentially as Drawn

Permit can be suspended or revoked if any false information is supplied toward securing the permit/any unauthorized changes are made to the site/any unauthorized changes are made in the installation of the system. Improvement Permit with plat valid without expiration. Improvement Permit with site plan valid for sixty months. Authorization to Construct is valid for a period equal to that of Improvement Permit – not to exceed sixty months.

Signed: date 8-25-05 Installed by: Richard Hoernemann RS 9/7/05

Improvement Permit by: RS date 7/29/03 Operation Permit by: Maria H. Tolson RS date

Authorization to Construct by: Maria H. Tolson RS date 4/12/05 Existing System Inspection by: date

HEALTH DEPT. COPY: WHITE OWNER COPY (FINAL): YELLOW OWNER COPY (INITIAL): PINK