# IREDELL COUNTY HEALTH DEPARTMENT

STATESVILLE 704-878-5305 MOORESVILLE 704-664-5281

## IMPROVEMENT PERMIT / AUTHORIZATION TO CONSTRUCT / OPERATION PERMIT / EXISTING SYSTEM INSPECTIC

130

PERMIT# 112510 PIN# 4626637315.225 4626-63-4065 DATE 7/31/03

OWNER OR CONTRACTOR CRESCENT RESOURCES / WHITLEY CO. PHONE: Business 660-1185 Home

ADDRESS 2214 BRAWLEY SCHOOL - MOORESVILLE NC 28117

LOCATION BRAWLEY SCHOOL - TR SOUTHFORK - TL FRESHWATER - TR RAOSDALE - ON LT

SUBDIVISION THE FARMS BLOCK / SECTION 2 LOT 225 LOT AREA 1.91AC SITE CLASS. RS DESIGN FLOW 480GPD L.T.A.R. .3600/F12

Septic Tank: 1000 Gallons; STB 336 Date 9/24/04
Pump Tank: 1000 Gallons; PT 283 Date 9/9/04
Pump Make: Goulds Model WE0712HU Serial No.
Nitrification Field: No Fields 1 Square Feet 1200 Linear Feet 400
No Lines ~~5@30'~~ Trench Width 36" Max Trench Bottom Depth 36" Gravel Depth N/A

☑ New System ☐ Repair System Type: I, II, III, IV, V, VI
System Description: PUMP 25% REDUCTION
Repair System Description: LP PANEL
Maintenance Agreement Required: ☐ Yes ☑ No

☑ House/Mod. Home No. Bedrooms 4
☐ Mobile Home No. Bathrooms 4
☐ Business No. Employees
☐ Other


☐ Slab ☑ Crawl Space ☐ Basement w/plumbing ☐ Basement wo/plumbing

Water Supply: ☐ Individual ☐ Public ☑ ~~Community~~


Comments:/Conditions: (60 LF unfalled)

Comments:/Conditions: PARTIAL 11/16/04 WS Checked Lines, tanks & pressure Plastic Chambers installed

INITIAL SITE SKETCH 1"=50'

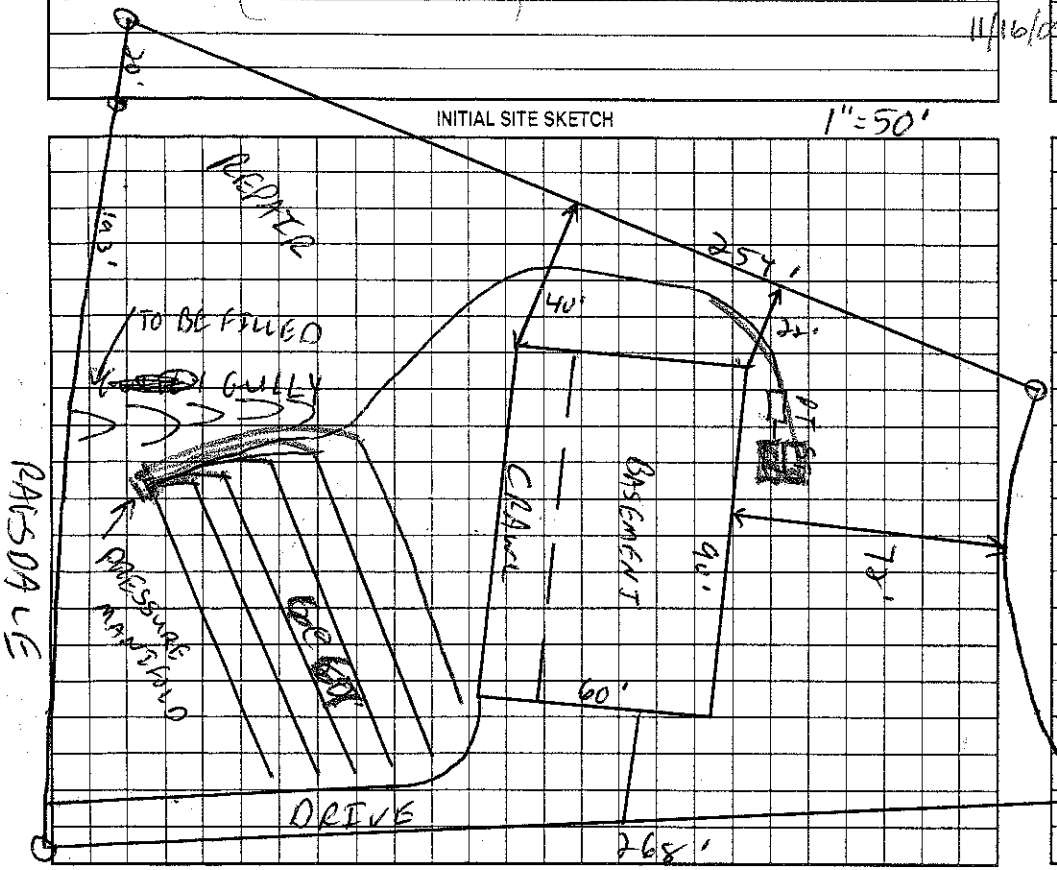


AS BUILT SKETCH

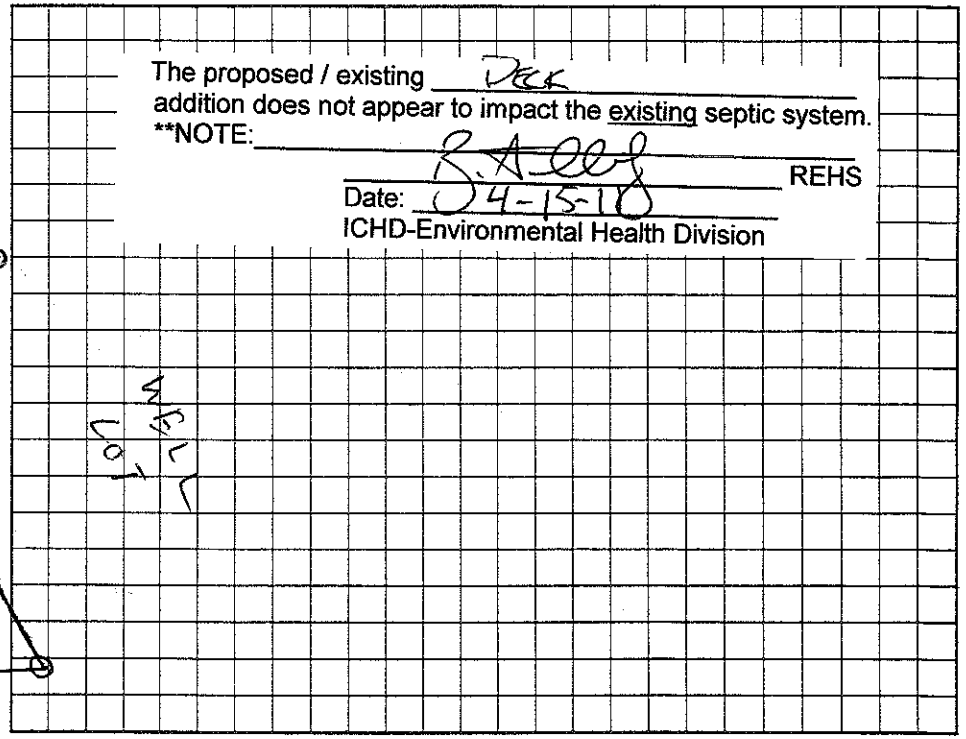


The proposed / existing Deck addition does not appear to impact the existing septic system.
**NOTE:

REHS
Date: 04-15-10
ICHD-Environmental Health Division

Permit can be suspended or revoked if any false information is supplied toward securing the permit/any unauthorized changes are made to the site/any unauthorized changes are made in the installation of the system. Improvement Permit with plat valid without expiration. Improvement Permit with site plan valid for sixty months. Authorization to Construct is valid for a period equal to that of Improvement Permit – not to exceed sixty months.

Signed: date 8-25-03 Installed by: Brent Bumgarner RS

Improvement Permit by: C. Shaw RS date 7/31/03 Operation Permit by: Mark H. Dotson RS date 12/6/04

Authorization to Construct by: C Shaw RS date 8/12/03 Existing System Inspection by: date

HEALTH DEPT. COPY: WHITE OWNER COPY (FINAL): YELLOW OWNER COPY (INITIAL): PINK