130

IREDELL COUNTY HEALTH DEPARTMENT

STATESVILLE 704-878-5305 MOORESVILLE 704-664-5281

IMPROVEMENT PERMIT / AUTHORIZATION TO CONSTRUCT / OPERATION PERMIT / EXISTING SYSTEM INSPECTION

PERMIT# 112401 PIN# 4626637315.203 4626-63-5363 DATE 7/29/03

OWNER OR CONTRACTOR CRESCENT RESOURCES / STONE BRIDGE HOMES PHONE: Business 660-1185 Home

ADDRESS 2214 BRAWLEY SCHOOL MOORESVILLE NC 28117

LOCATION BRAWLEY SCHOOL - TR SOUTHFORK - TL @ FRESHWATER - TR RAGSDALE - 2nd ON RT

SUBDIVISION THE FARMS BLOCK / SECTION 2 LOT 203 LOT AREA .71AC SITE CLASS PS DESIGN FLOW 480GPD L.T.A.R. .36GPD/FT²

Septic Tank: 1500 Gallons; STB 525 Date 7/27/04

Pump Tank: 1000 Gallons; PT 17 Date 2/28/06

Pump Make: Goulds Model WE03512HH Serial No. B0643174

Nitrification Field: No Fields 1 Square Feet 1200 Linear Feet 400

No Lines 4 @ 100' Trench Width 36" Max Trench Bottom Depth 36" Gravel Depth N/A

☑ New System ☐ Repair System Type: I, II, III, IV, V, VI

System Description: PUMP 25% REDUCTION LP PANEL

Repair System Description:

Maintenance Agreement Required: ☐ Yes ☑ No

☑ House/Mod. Home ☐ Mobile Home ☐ Business ☐ Other

No. Bedrooms 4 No. Bathrooms 4 No. Employees


☐ Slab ☑ Crawl Space ☐ Basement w/plumbing ☐ Basement wo/plumbing

Water Supply: ☐ Individual ☐ Public ☑ Community


Comments:/Conditions: LC

Comments:/Conditions: Quick 4

INITIAL SITE SKETCH 1"=50'

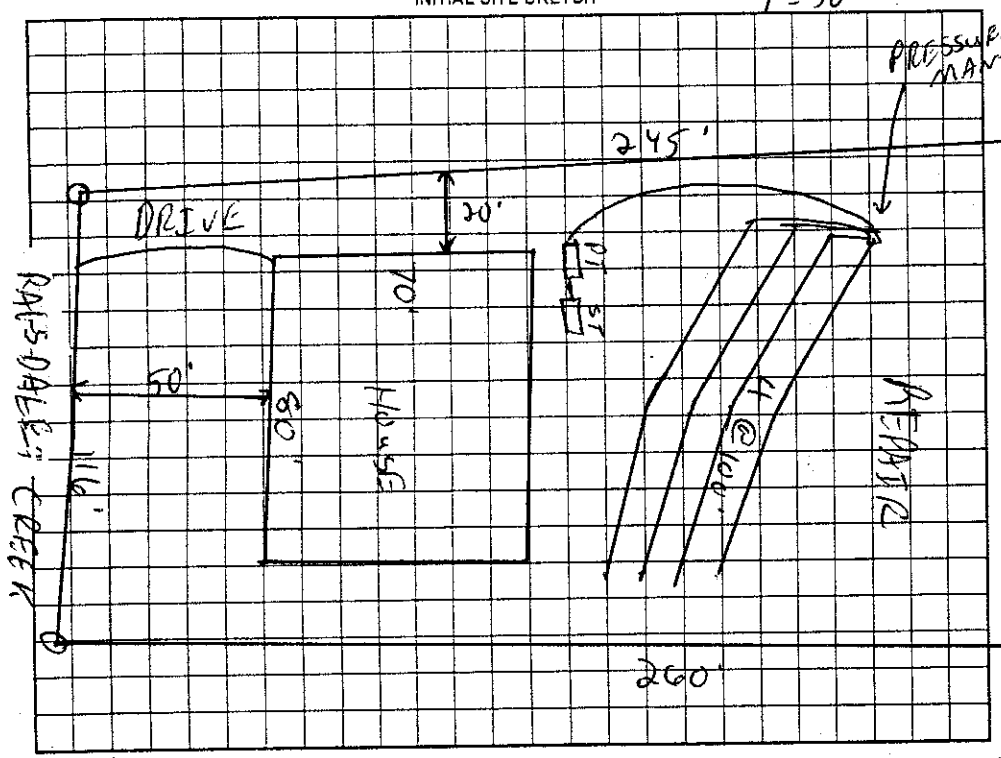

AS BUILT SKETCH

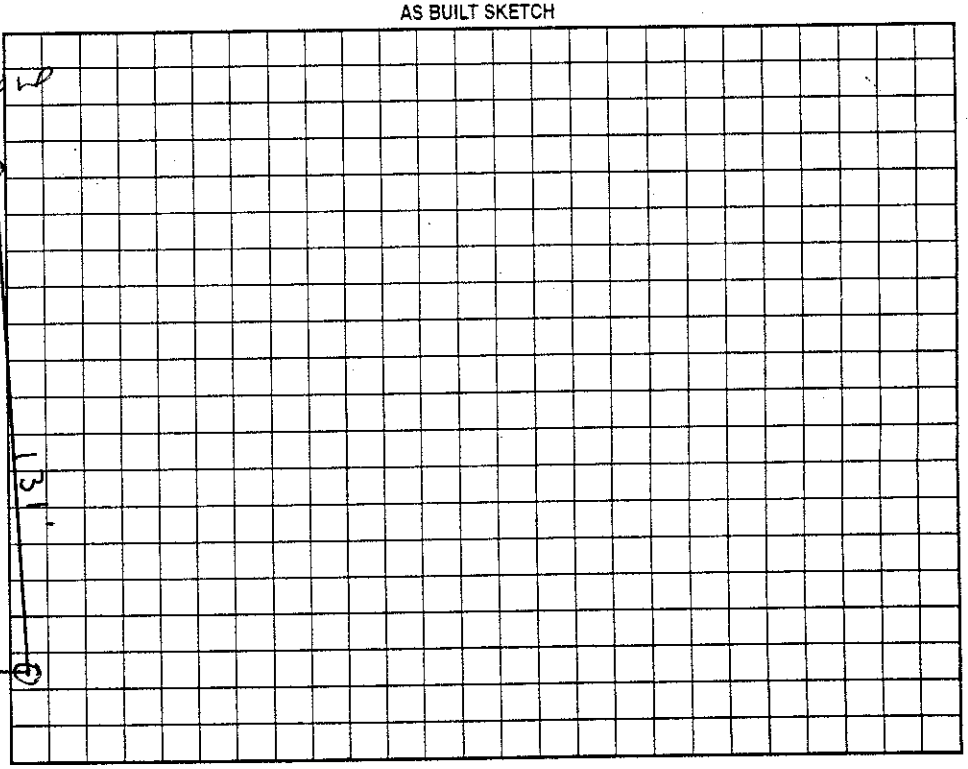

Permit can be suspended or revoked if any false information is supplied toward securing the permit/any unauthorized changes are made to the site/any unauthorized changes are made in the installation of the system. Improvement Permit with plat valid without expiration. Improvement Permit with site plan valid for sixty months. Authorization to Construct is valid for a period equal to that of Improvement Permit – not to exceed sixty months.

Signed: date 8-26-03 Installed by: Piedmont Excavation

Improvement Permit by: RS date 7/29/03 Operation Permit by: RS date 5/16/06

Authorization to Construct by: RS date 6/24/03 Existing System Inspection by: date

HEALTH DEPT. COPY: WHITE OWNER COPY (FINAL): YELLOW OWNER COPY (INITIAL): PINK