IREDELL COUNTY HEALTH DEPARTMENT

STATESVILLE 704-878-5305 50.00 Paid MOORESVILLE 704-664-5281

IMPROVEMENT PERMIT / AUTHORIZATION TO CONSTRUCT / OPERATION PERMIT / EXISTING SYSTEM INSPECTION

PERMIT# 111178 PIN# ~~4626 63 7315.1~~ 4626-63-5828 DATE 4/26/04

OWNER OR CONTRACTOR Life Styles Homes PHONE: Business 704-795-1733 Home

ADDRESS 65 Mc Cundy St. Concord, NC 28027

LOCATION 1100 TR South fork 1/2 mile right on Kay Place (L) on W. Clebrook (L) Dixon Morris on (L) off lake side

SUBDIVISION Farms BLOCK / SECTION 1 LOT 7 LOT AREA .89 SITE CLASS P5 DESIGN FLOW 600 L.T.A.R. .25

Septic Tank: 1500 Gallons; STB 338 Date 8/14/04
Pump Tank: 1500 Gallons; PT 477 Date 7/31/04
Pump Make: Envirs Model NE0512HHS Serial No T0404352
Nitrification Field: No Fields 1 Square Feet 800/1200 Linear Feet 400
No Lines 4 @ 100' Trench Width 2' - 3' Max Trench Bottom Depth 3'

☒ New System ☐ Repair System Type: I, II, III, IV, V, VI
System Description: PreMonto 16" PPBPS
Repair System Description: 16" PPBPS
Maintenance Agreement Required: ☐ Yes ☐ No

☒ House/Mod. Home No. Bedrooms 5
☐ Mobile Home No. Bathrooms 4.5
☐ Business No. Employees
☐ Other
Gravel Depth No ☐ Slab ☒ Crawl Space ☐ Basement w/plumbing ☐ Basement wo/plumbing


Water Supply: ☐ Individual ☐ Public ☒ Community

Comments/Conditions: 2' = 8' Centers (4') = 9' Centers


Comments/Conditions: 92- Panels installed
3' trenches installed

(1" = 50')

INITIAL SITE SKETCH

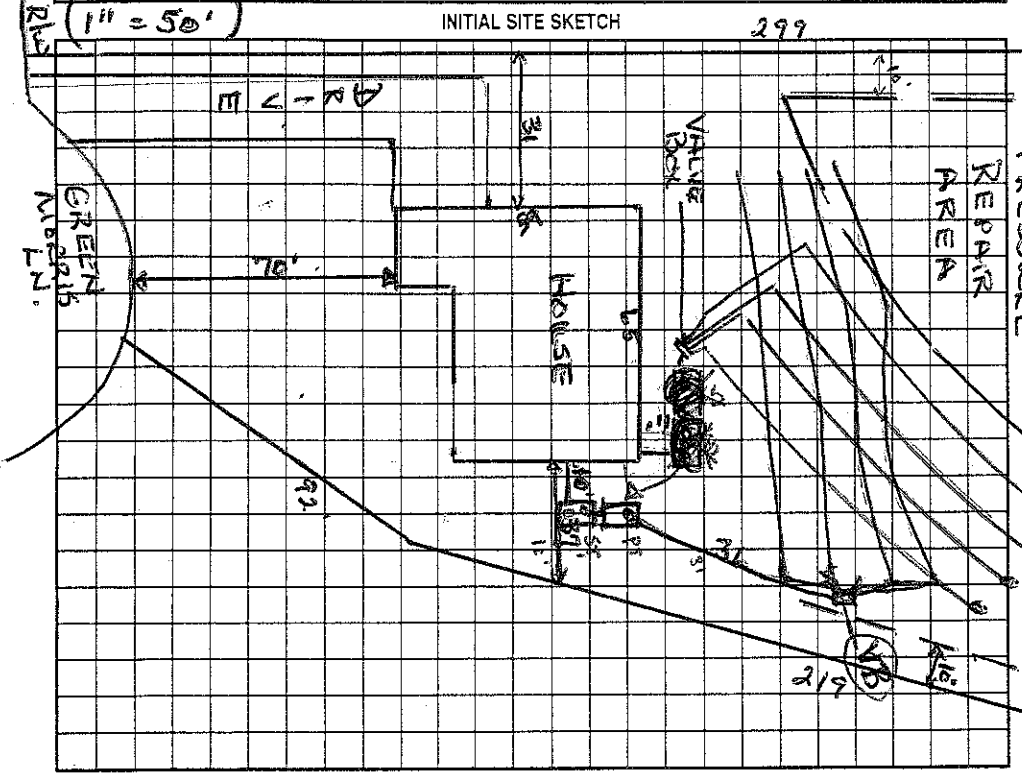

AS BUILT SKETCH

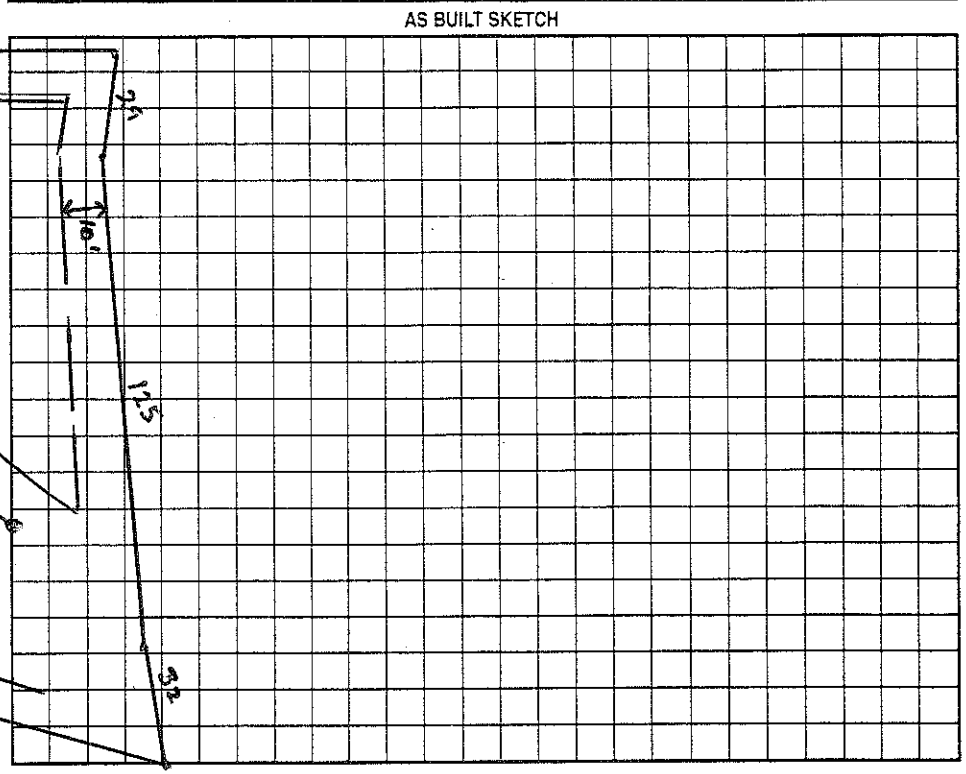

Permit can be suspended or revoked if any false information is supplied toward securing the permit/any unauthorized changes are made to the site/any unauthorized changes are made in the installation of the system. Improvement Permit with plat valid without expiration. Improvement Permit with site plan valid for sixty months. Authorization to Construct is valid for a period equal to that of Improvement Permit – not to exceed sixty months.

Signed: [signature] date 4/27/04 Installed by: Hallmon Const.

Improvement Permit by: Wesley Sparks R.S. date 4/26/04 Operation Permit by: Wesley Sparks R.S. date 11/1/04

Authorization to Construct by: Wesley Sparks R.S. date 4/26/04 Existing System Inspection by: date

HEALTH DEPT. COPY: WHITE OWNER COPY (FINAL): YELLOW OWNER COPY (INITIAL): PINK