IREDELL COUNTY HEALTH DEPARTMENT *ENVIRONMENTAL HEALTH DIVISION*:

SITE PLAN WORKSHEET

SEE THE "SAMPLE SITE PLAN" BELOW. ***INCOMPLETE SITE PLANS WILL BE RETURNED TO YOU FOR COMPLETION AND MAY RESULT IN A DELAY IN THE ISSUANCE OF YOUR SEPTIC SYSTEM PERMIT!!!***

Place an (X) beside each item as you complete the site plan:


- ✓ **Property Line measurements are clearly identified...**
- ✓ **All proposed structures are indicated...**

SHOW: proposed house or business footprint, wells, water lines, patios, pools and decks, and any other item that will occupy space on the site


- ✓ **Front and side setbacks from property line...**
- ✓ **Preferred driveway location and configuration, preferred well location...**
- ✓ **Area you prefer your septic system to be placed...**
- ✓ **North arrow, or other sufficient indicator of direction...**

Circle N/A on the following if appropriate:

- ✓ **Location of septic systems and wells within 100' of your property... N/A**
- **Location of easements and rights of ways on your property... N/A**
- A C **Location of any designated wetlands on the property... N/A**

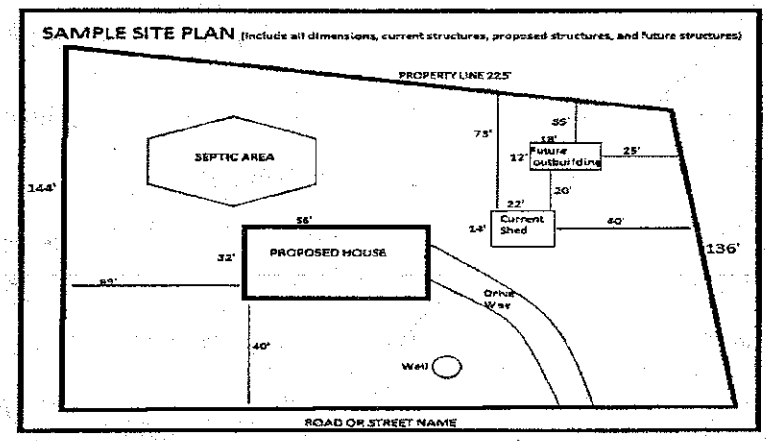

USE THIS SPACE TO DRAW YOUR SITE PLAN

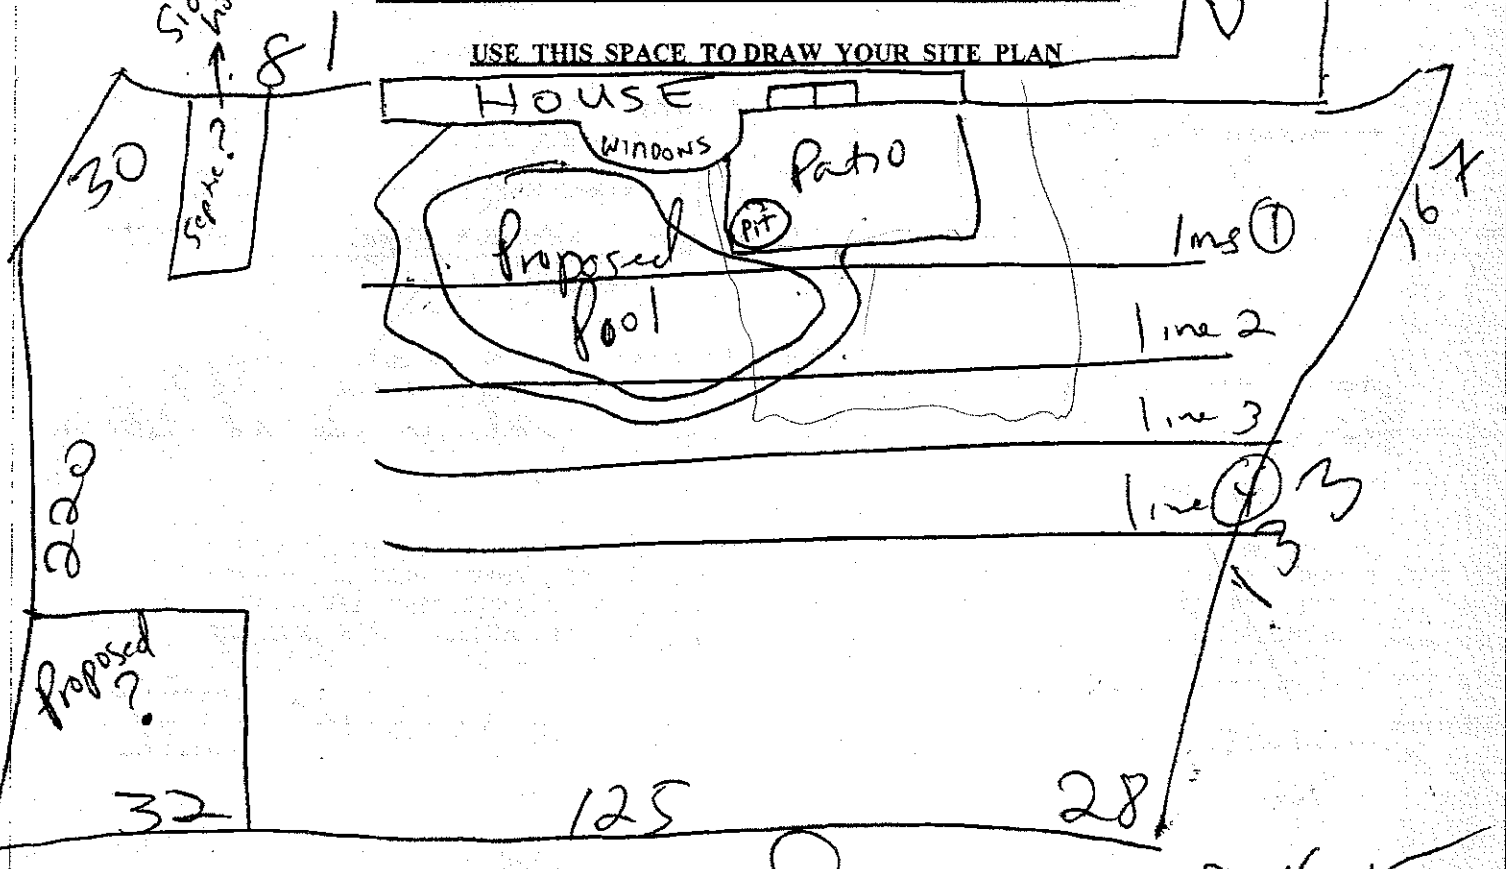

Signature: _____

REQUIRED **property owner or owner's legal representative signature.**

8-4-15

DATE

IREDELL COUNTY HEALTH DEPARTMENT

STATESVILLE 704-878-5305 500.00 Paid MOORESVILLE 704-664-5281

IMPROVEMENT PERMIT / AUTHORIZATION TO CONSTRUCT / OPERATION PERMIT / EXISTING SYSTEM INSPECTION

PERMIT# 11179 PIN# 4626-62-7346 4626-63-5828 DATE 4/26/04

OWNER OR CONTRACTOR Life Style Homes PHONE: Business 704-795-1733 Home

ADDRESS 65 Mc Cindy St. Concord, NC 28027

LOCATION Hwy 72 South for ½ mile right on Key Haven (L) on Cobble Hill (L) Green Manor on L. Hyacinth

SUBDIVISION Fairmont BLOCK / SECTION 1 COT 7 LOT AREA .89 SITE CLASS P3 DESIGN FLOW 600 L.T.A.R. .42 .25

Septic Tank: 1600 Gallons: STB 333 Date 3/19/04 | ☒ New System ☐ Repair System Type: I, II, III, IV, V | ☒ House/Mod. Home No. Bedrooms 3 | Water Supply: ☐ Individual ☐ Public ☒ Community

Pump Tank: 1500 Gallons: PT 477 Date 3/31/04 | System Description: Pond Master 16" PABPS | ☐ Mobile Home No. Bathrooms 2.5

Pump Make: Crispwell Model WEC 517 H Serial No. Tank 1352 | Repair System Description: 16" PABPS | ☐ Business No. Employees

Nitrification Field: No Fields 1 Square Feet 800/1200 Linear Feet 400 | Maintenance Agreement Required: ☐ Yes ☐ No | ☐ Other


No. Lines 4 @ 10' Trench Width 2' - 3' Max Trench Bottom Depth 3' Gravel Depth N/A ☐ Slab ☒ Crawl Space ☐ Basement w/plumbing ☐ Basement w/o plumbing

Comments/Conditions: 2' = 8' Centers (4) = 9' Centers


Comments/Conditions: 92- Panels installed 3' Trenches installed

(1" = 50')

INITIAL SITE SKETCH

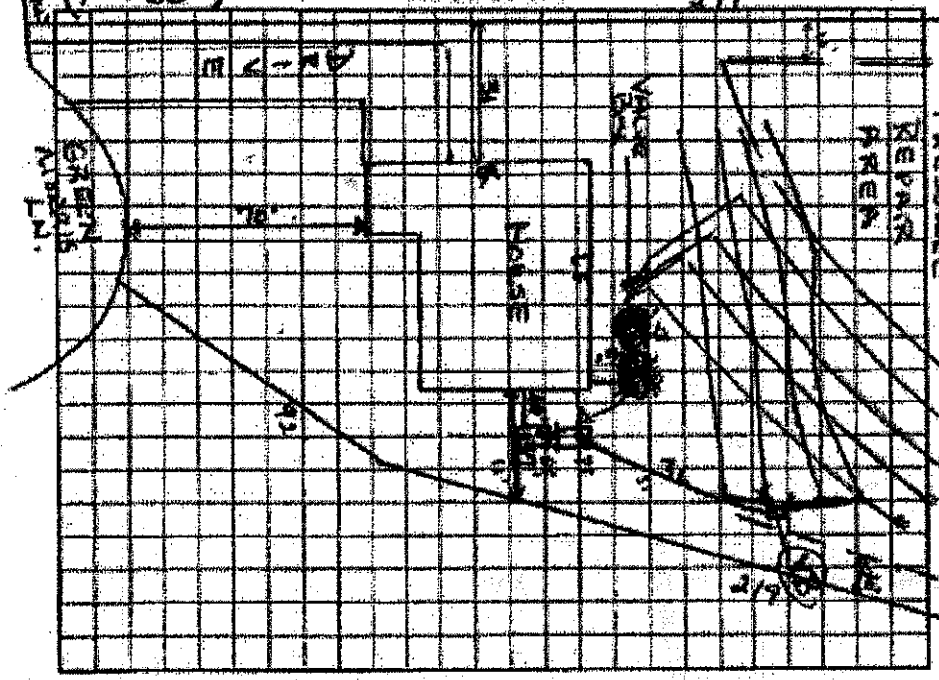

AS BUILT SKETCH

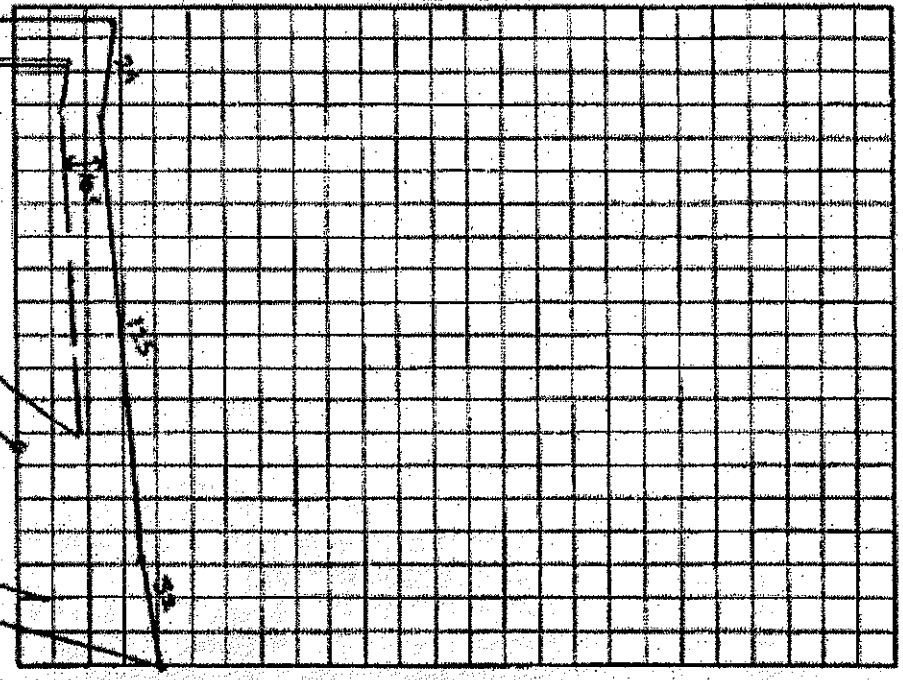

Permit can be suspended or revoked if any false information is supplied toward securing the permit/any unauthorized changes are made to the site/any unauthorized changes are made in the installation of the system. Improvement Permit with plat valid without expiration. Improvement Permit with site plan valid for sixty months. Authorization to Construct is valid for a period equal to that of Improvement Permit – not to exceed sixty months.

Signed: [signature] date 4/27/04 Installed by: Hall Long Const.

Improvement Permit by: Wesley Sparks R.S. date 4/26/04 Operation Permit by: Wesley Sparks R.S. date 11/1/04

Authorization to Construct by: Wesley Sparks R.S. date 4/26/04 Existing System Inspection by: date

HEALTH DEPT COPY WHITE OWNER COPY (FINAL) YELLOW OWNER COPY (INITIAL) PINK