4626637220 130

IREDELL COUNTY HEALTH DEPARTMENT

STATESVILLE 704-878-5305 MOORESVILLE 704-664-5281

IMPROVEMENT PERMIT / AUTHORIZATION TO CONSTRUCT / OPERATION PERMIT / EXISTING SYSTEM INSPECTION

PERMIT# 12399 PIN# 4626637315.202 Stonebridge Lnwy DATE 5/29/03

OWNER OR CONTRACTOR CRESCENT RESOURCES/LK FOREST ESTLLC PHONE: Business 660-1185 Home

ADDRESS 7214 BRAWLEY SCHOOL MOORESVILLE NC 28117

LOCATION BRAWLEY SCHOOL - TR SOUTH FORK - TL JERSEY WATER - 2nd ON RT

SUBDIVISION THE FARMS BLOCK / SECTION II LOT 202 LOT AREA 1.83AC SITE CLASS. RS DESIGN FLOW 480GPD L.T.A.R. .36GPD/FT2

Septic Tank: ~~1000~~/1250 Gallons; STB 338 Date 11/22/04

Pump Tank: Gallons; PT Date

Pump Make: Model Serial No.

Nitrification Field: No Fields 1 Square Feet 1200 Linear Feet 400

No Lines 4@100' Trench Width 36" Max Trench Bottom Depth 36" Gravel Depth N/A

☑ New System ☐ Repair System Type: I, II, (III), IV, V, VI

System Description: GRAVITY 25% REDUCTION

Repair System Description: LP PANEL

Maintenance Agreement Required: ☐ Yes ☑ No

☑ House/Mod. Home No. Bedrooms 4

☐ Mobile Home No. Bathrooms 4

☐ Business No. Employees

☐ Other


☐ Slab ☑ Crawl Space ☐ Basement w/plumbing ☐ Basement wo/plumbing

Water Supply: ☑ Individual ☐ Public ☑ Community


Comments:/Conditions: Reviewed Site plans & building plans & essentially in Compliance with original permit.

Comments:/Conditions:

INITIAL SITE SKETCH

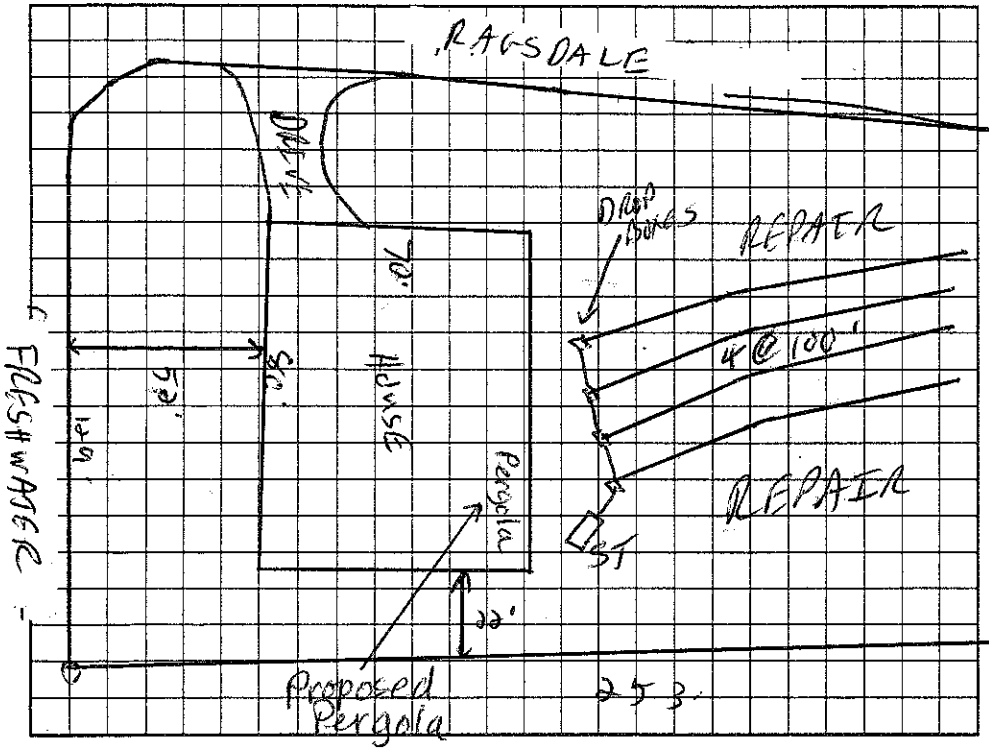

AS BUILT SKETCH

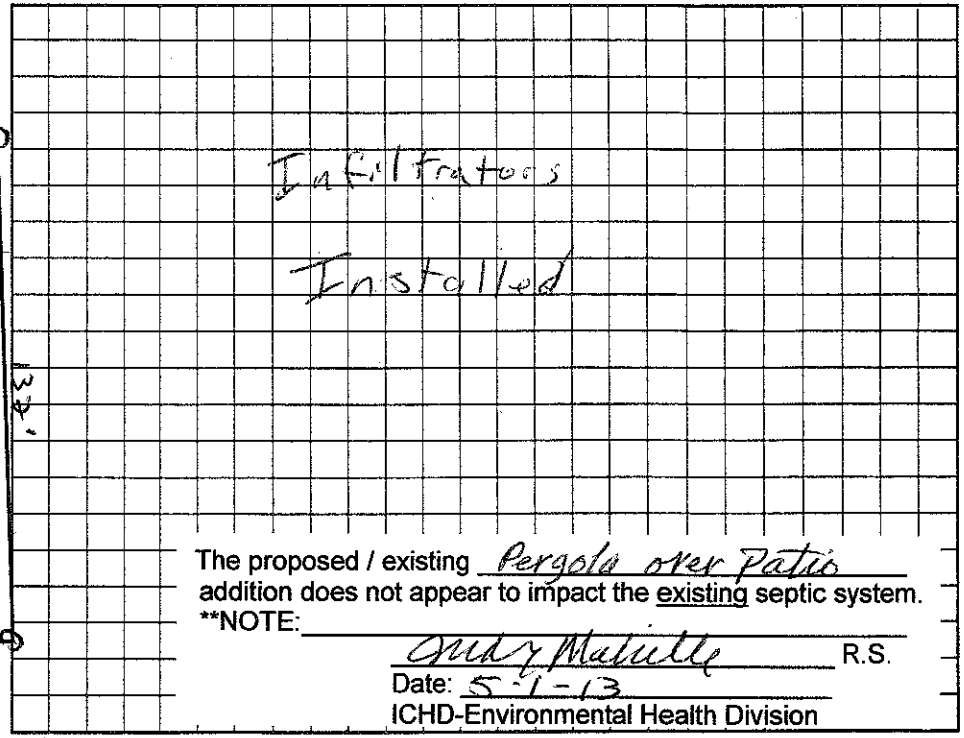

The proposed / existing Pergola over Patio addition does not appear to impact the existing septic system.

**NOTE:

Andy Melville R.S.

Date: 5-1-13

ICHD-Environmental Health Division

Permit can be suspended or revoked if any false information is supplied toward securing the permit/any unauthorized changes are made to the site/any unauthorized changes are made in the installation of the system. Improvement Permit with plat valid without expiration. Improvement Permit with site plan valid for sixty months. Authorization to Construct is valid for a period equal to that of Improvement Permit – not to exceed sixty months.

Signed: date 9-25-03 Installed by: Steve Jordan

Improvement Permit by: RS date 7/24/03 Operation Permit by: RS date 12/29/04

Authorization to Construct by: RS date 3/17/04 Existing System Inspection by: date

HEALTH DEPT. COPY: WHITE OWNER COPY (FINAL): YELLOW OWNER COPY (INITIAL): PINK