IREDELL COUNTY HEALTH DEPARTMENT

STATESVILLE 704-878-5305 MOORESVILLE 704-664-5281

IMPROVEMENT PERMIT / AUTHORIZATION TO CONSTRUCT / OPERATION PERMIT / EXISTING SYSTEM INSPECTION

PERMIT# 112396 PIN# 4626 63 73 15.201 7626637363 DATE 7/18/03

OWNER OR CONTRACTOR ~~THE FARMS~~ CRESCENT RESOURCES/John R Poore PHONE: Business 660-1185 Home

ADDRESS 214 BRAWLEY SCHOOL RD. MOORESVILLE NC 28117

LOCATION BRAWLEY SCHOOL - JR SOUTH FORK - LT FRESH WATER ON LT CORNER

SUBDIVISION FARMS BLOCK / SECTION LOT 201 LOT AREA .79AC SITE CLASS. PS DESIGN FLOW 480GPD L.T.A.R. .36PD/FT2

Septic Tank: 1000 Gallons; STB 338 Date 4-19-05

Pump Tank: Gallons; PT Date

Pump Make: Model Serial No.

Nitrification Field: No Fields 1 Square Feet 200 Linear Feet 400

No Lines 4@100' Trench Width 36" Max Trench Bottom Depth 36" Gravel Depth N/A

☑ New System ☐ Repair System Type: I, II, (III) IV, V, VI

System Description: GRAVITY 25% REDUCTION

Repair System Description: LP PANEL

Maintenance Agreement Required: ☐ Yes ☑ No

☑ House/Mod. Home No. Bedrooms 4

☐ Mobile Home No. Bathrooms 4

☐ Business No. Employees

☐ Other


☐ Slab ☑ Crawl Space ☐ Basement w/plumbing ☐ Basement wo/plumbing

Water Supply: ☐ Individual ☐ Public ☑ ~~Community~~


Comments:/Conditions:

Comments:/Conditions: See revised/existing Septic System permit dtd 3/30/06 for Swimming Pool

INITIAL SITE SKETCH 1"=50'

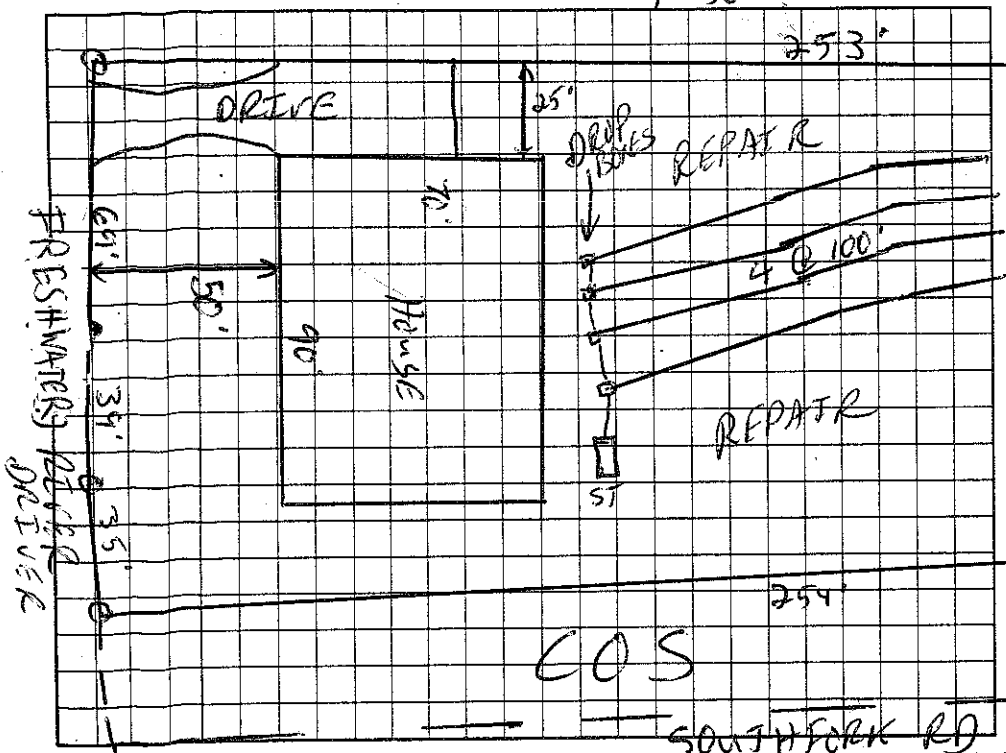

AS BUILT SKETCH

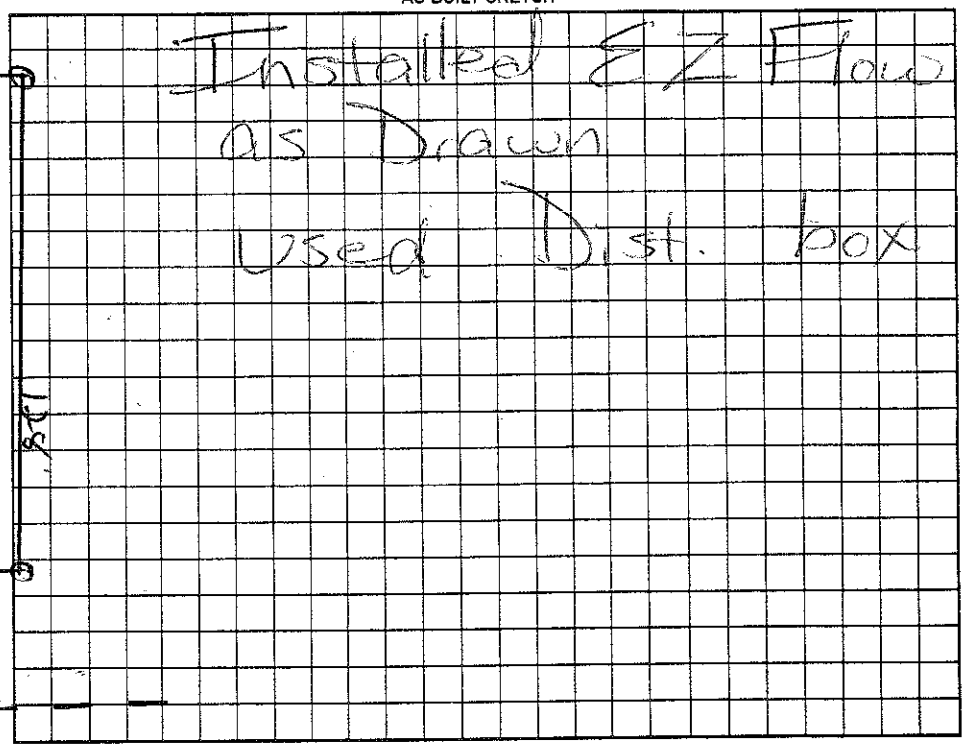

Permit can be suspended or revoked if any false information is supplied toward securing the permit/any unauthorized changes are made to the site/any unauthorized changes are made in the installation of the system. Improvement Permit with ~~plat~~ valid without expiration. Improvement Permit with site plan valid for sixty months. Authorization to Construct is valid for a period equal to that of Improvement Permit – not to exceed sixty months.

Signed: date 8-23-04 Installed by: R & H RS

Improvement Permit by: RS date 7/18/03 Operation Permit by: Mark Dotson date 5/26/05

Authorization to Construct by: RS date 3/2/04 Existing System Inspection by: date

HEALTH DEPT. COPY: WHITE OWNER COPY (FINAL): YELLOW OWNER COPY (INITIAL): PINK