IREDELL COUNTY HEATLH DEPARTMENT

PAGE 2: *SITE PLAN WORKSHEET*

SEE THE SAMPLE SITE PLAN BELOW. INCOMPLETE SITE PLANS WILL BE RETURNED TO YOU FOR COMPLETION AND MAY RESULT IN A DELAY IN THE ISSUANCE OF YOUR SEPTIC SYSTEM PERMIT!!!

Place an (X) beside each item as you complete the site plan:

____ Property Line measurements are clearly identified...
____ All proposed structures are indicated...
SHOW: proposed house or business footprint, wells, water lines, patios, pools and decks, and any other item that will occupy space on the site
____ Front and side setbacks from property line...
____ Preferred driveway location and configuration, preferred well location...
____ Area you prefer your septic system to be placed...
____ North arrow, or other sufficient indicator of direction...

Circle N/A on the following if appropriate:


____ Location of septic systems and wells within 100' of your property... N/A
____ Location of easements and rights of ways on your property... N/A
____ Location of any designated wetlands on the property... N/A

Signature: Tony Cook 4/3/24

Property owner or owner's legal representative signature (SIGNATURE REQUIRED) DATE

USE THIS SPACE TO DRAW YOUR SITE PLAN

enclosed

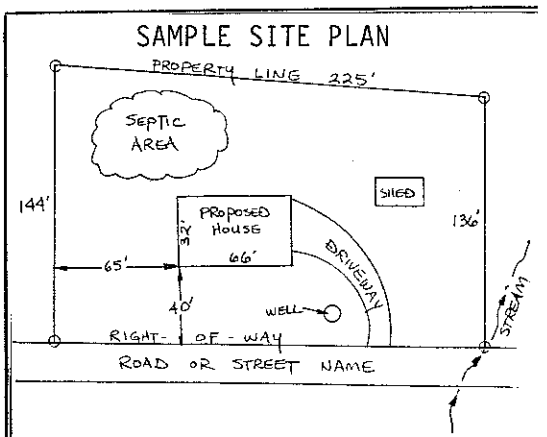

130

IREDELL COUNTY HEALTH DEPARTMENT

STATESVILLE 704-878-5305 MOORESVILLE 704-664-5281

IMPROVEMENT PERMIT / AUTHORIZATION TO CONSTRUCT / OPERATION PERMIT / EXISTING SYSTEM INSPECTION

PERMIT# 112-396 PIN# 4626 63 73 15.201 DATE 7/18/03

OWNER OR CONTRACTOR ~~THE OWNERS~~ CRESCENT RESOURCES/John R Poore PHONE: Business 660-1185 Home

ADDRESS 2214 BRAWLEY SCHOOL RD MOORESVILLE NC 28117

LOCATION BRAWLEY SCHOOL - JR SOUTHFORK - TL FRESHWATER CV LT CORNER

SUBDIVISION FARMS BLOCK / SECTION LOT 201 LOT AREA .794C SITE CLASS. RS DESIGN FLOW 480GPD L.T.A.R. .30 MD/FT 2

Septic Tank: 1000 Gallons; STB 338 Date 1-19-05

Pump Tank: Gallons; PT Date

Pump Make: Model Serial No.

Nitrification Field: No Fields 1 Square Feet 200 Linear Feet 400

No Lines 4@100' Trench Width 36" Max Trench Bottom Depth 36" Gravel Depth N/A

☑ New System ☐ Repair System Type: I, II, (III) IV, V, VI

System Description: GRAVITY 25% REDUCTION

Repair System Description: LP PANEL

Maintenance Agreement Required: ☐ Yes ☑ No

☑ House/Mod. Home No. Bedrooms 4

☐ Mobile Home No. Bathrooms 4

☐ Business No. Employees

☐ Other


☐ Slab ☑ Crawl Space ☐ Basement w/plumbing ☐ Basement wo/plumbing

Water Supply: ☐ Individual ☐ Public ☑ ~~Community~~


Comments:/Conditions:

Comments:/Conditions:

INITIAL SITE SKETCH 1"=50'

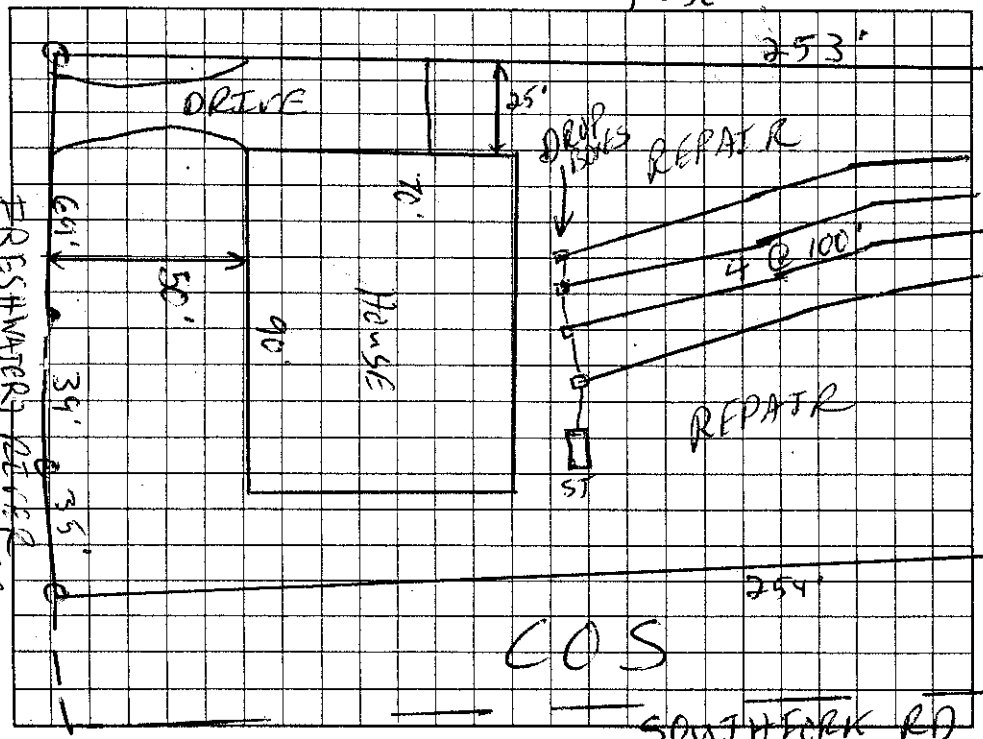

AS BUILT SKETCH

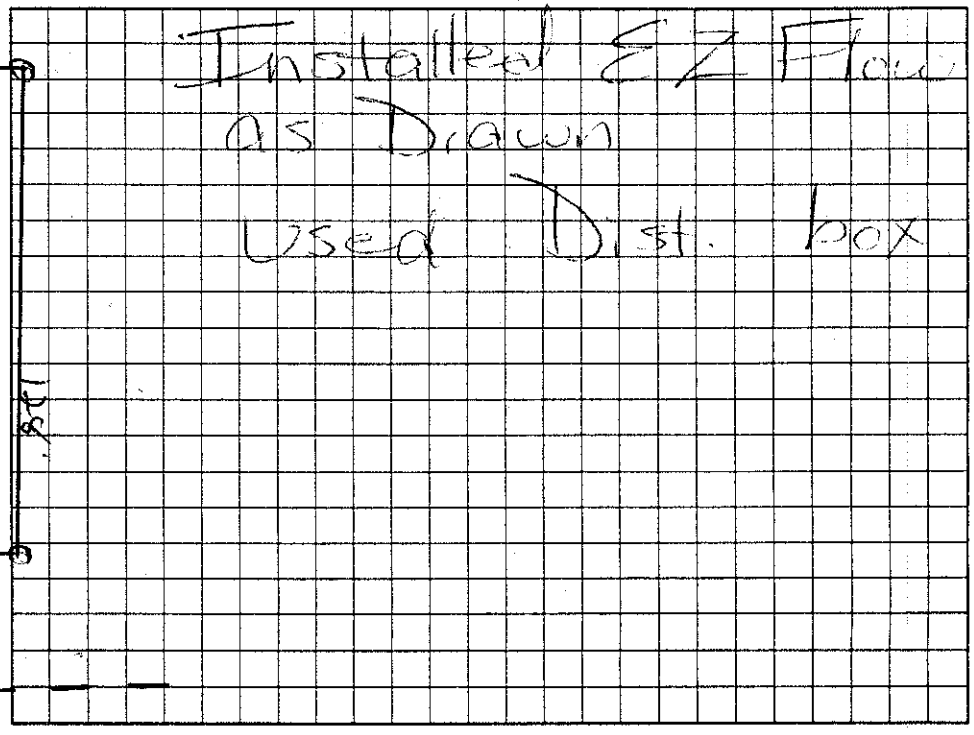

Permit can be suspended or revoked if any false information is supplied toward securing the permit/any unauthorized changes are made to the site/any unauthorized changes are made in the installation of the system. Improvement Permit with plat valid without expiration. Improvement Permit with site plan valid for sixty months. Authorization to Construct is valid for a period equal to that of Improvement Permit – not to exceed sixty months.

Signed: date 8-23-04 Installed by: RH Dotson KS

Improvement Permit by: KS date 7/18/03 Operation Permit by: Mariah H Dotson date 5

Authorization to Construct by: KS date 3/24/04 Existing System Inspection by: date /

HEALTH DEPT. COPY: WHITE OWNER COPY (FINAL): YELLOW OWNER COPY (INITIAL): PINK