IREDELL COUNTY HEALTH DEPARTMENT

4626 38 6610

#130

STATESVILLE 704-878-5305 MOORESVILLE 704-664-5281

IMPROVEMENT PERMIT / AUTHORIZATION TO CONSTRUCT / OPERATION PERMIT / EXISTING SYSTEM INSPECTION

PERMIT# 111150 PIN# 4626-63-7315.1 DATE June 12, 03

OWNER OR CONTRACTOR Crescent Resources Inc ~~Lake Forest Estate~~ Simonini PHONE: Business 201-59976 Home

ADDRESS P.O. Box 1003, Charlotte N.C.

LOCATION Brawley Sch Rd. TR South Fork Rd. TR Kapp Place 1st lot on left

SUBDIVISION THE FARMS BLOCK / SECTION 1 LOT 1 LOT AREA .851 Ac SITE CLASS PS DESIGN FLOW 480gpd L.T.A.R. .03

Septic Tank: 1000 Gallons; STB 338 Date 5-10-04
Pump Tank: Gallons; PT Date
Pump Make: Model Serial No.
Nitrification Field: No Fields 2 Square Feet 1200 Linear Feet 400
No Lines 2+2 Trench Width 36" Max Trench Bottom Depth 36"

☑ New System ☐ Repair System Type: I, II, III, IV, V, VI
System Description: Gravity 25% Reduction LPPPBRS
Repair System Description:
Maintenance Agreement Required: ☐ Yes ☑ No initially
Gravel Depth NA ☐ Slab ☑ Crawl Space ☐ Basement w/plumbing ☐ Basement wo/plumbing

☑ House/Mod. Home No. Bedrooms 4
☐ Mobile Home No. Bathrooms 4
☐ Business No. Employees
☐ Other


Water Supply: ☐ Individual ☑ Public ☑ Community

Comments/Conditions: Reviewed Building plans & Site plan; essentially in Compliance with Original permit


Comments/Conditions: 6/11/04 After shooting evaluations of Drainlines, it was determined only 1-D-box necessary w/no Flow divider Checked tank & lines 6/11/04 mp

1"=50'

INITIAL SITE SKETCH

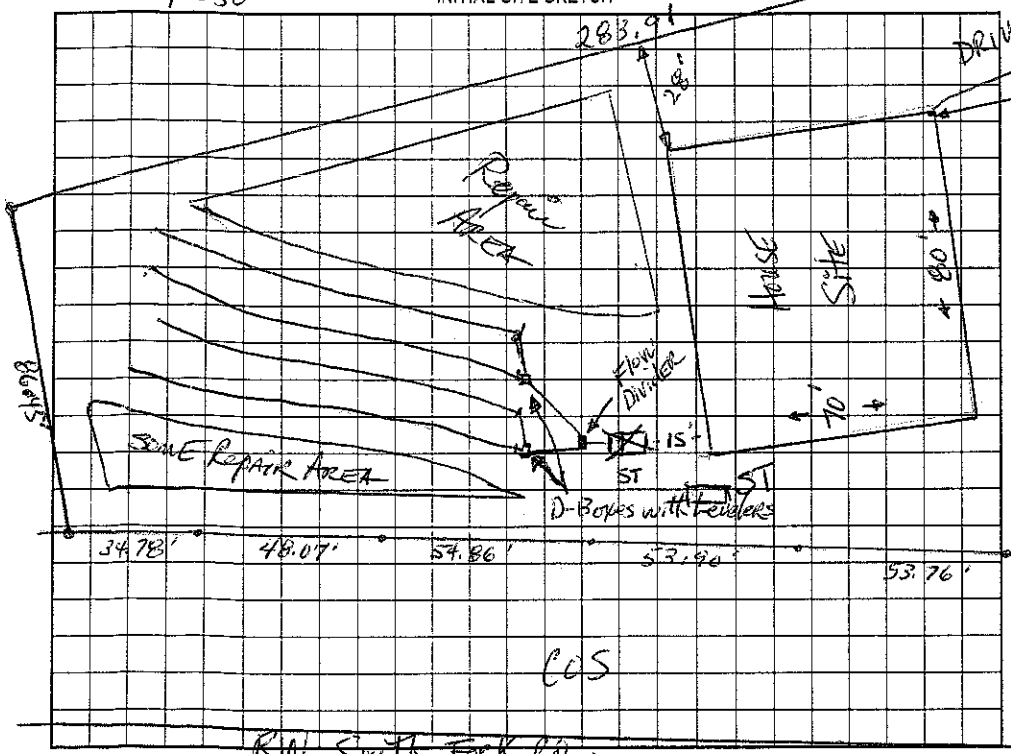

AS BUILT SKETCH

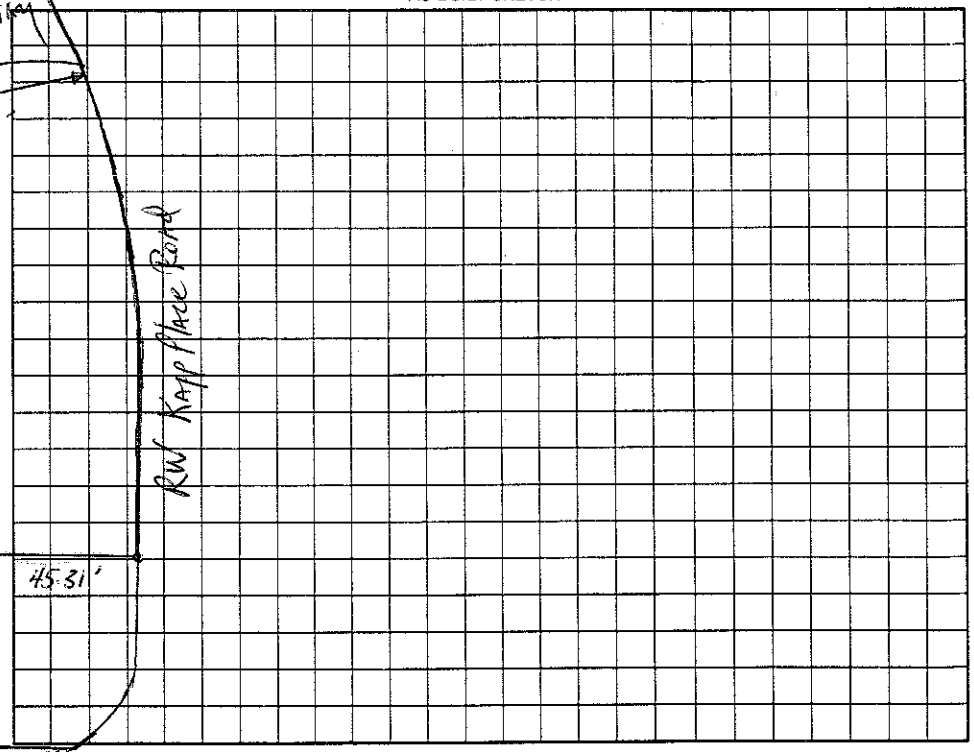

Permit can be suspended or revoked if any false information is supplied toward securing the permit/any unauthorized changes are made to the site/any unauthorized changes are made in the installation of the system. Improvement Permit with plat valid without expiration. Improvement Permit with site plan valid for sixty months. Authorization to Construct is valid for a period equal to that of Improvement Permit – not to exceed sixty months.

Signed: date 6-27-03 Installed by: R&H RS

Improvement Permit by: Mark D. Thompson, RS date June 12, 03 Operation Permit by: Maria H. Dotson RS date 6/17/04

Authorization to Construct by: Maria H. Dotson RS date 4/5/04 Existing System Inspection by: date

HEALTH DEPT. COPY: WHITE OWNER COPY (FINAL): YELLOW OWNER COPY (INITIAL): PINK