IREDELL COUNTY HEALTH DEPARTMENT

STATESVILLE 704-878-5305 MOORESVILLE 704-664-5281

375

IMPROVEMENT PERMIT / AUTHORIZATION TO CONSTRUCT / OPERATION PERMIT / EXISTING SYSTEM INSPECTION

PERMIT# 111152 PIN# 4626-63-7315.11 4626-64-1083 DATE June 16, 03

OWNER OR CONTRACTOR Crescent Resources/Bluff Lake Forest LLC/LIFESTYLE Co PHONE# Business Home

ADDRESS P.O. Box 1003 Charlotte N.C.

LOCATION Brawley S.h Rd. TR South Fork Bear Right on Agnew TR GREEN Morris - house on Right near end - SFE on West Callicutt TR

SUBDIVISION The FARMS I BLOCK / SECTION 1 LOT 11/11A LOT AREA 47443 + 33781 SF SITE CLASS. PS DESIGN FLOW 480gpd L.T.A.R. ~.225 Acres

Septic Tank: 1500 Gallons; STB 338 Date 4/16/04

Pump Tank: 500 Gallons; PT 421 Date 4/12/04

Pump Make: GOULDS Model WE1512 HGL Serial No. G03L249160 1HP

Nitrification Field: No Fields 1 Square Feet 880/1200 Linear Feet 352

No Lines 4@100' Trench Width 24"AW 36" Max Trench Bottom Depth 30" Gravel Depth NA

☑ New System ☐ Repair System Type: I, II, III, IV, V, VI

System Description: LPPPBPS

Repair System Description: LPPPBPS

Maintenance Agreement Required: ☑ Yes ☐ No

☑ House/Mod. Home No. Bedrooms 5 4

☐ Mobile Home No. Bathrooms 4

☐ Business No. Employees

☐ Other

☐ Slab ☐ Crawl Space ☑ Basement w/plumbing ☐ Basement wo/plumbing


Water Supply: ☐ Individual ☑ Public ☐ Community

Comments:/Conditions:


OR 36" MAX 90°C

Comments:/Conditions:

INITIAL SITE SKETCH

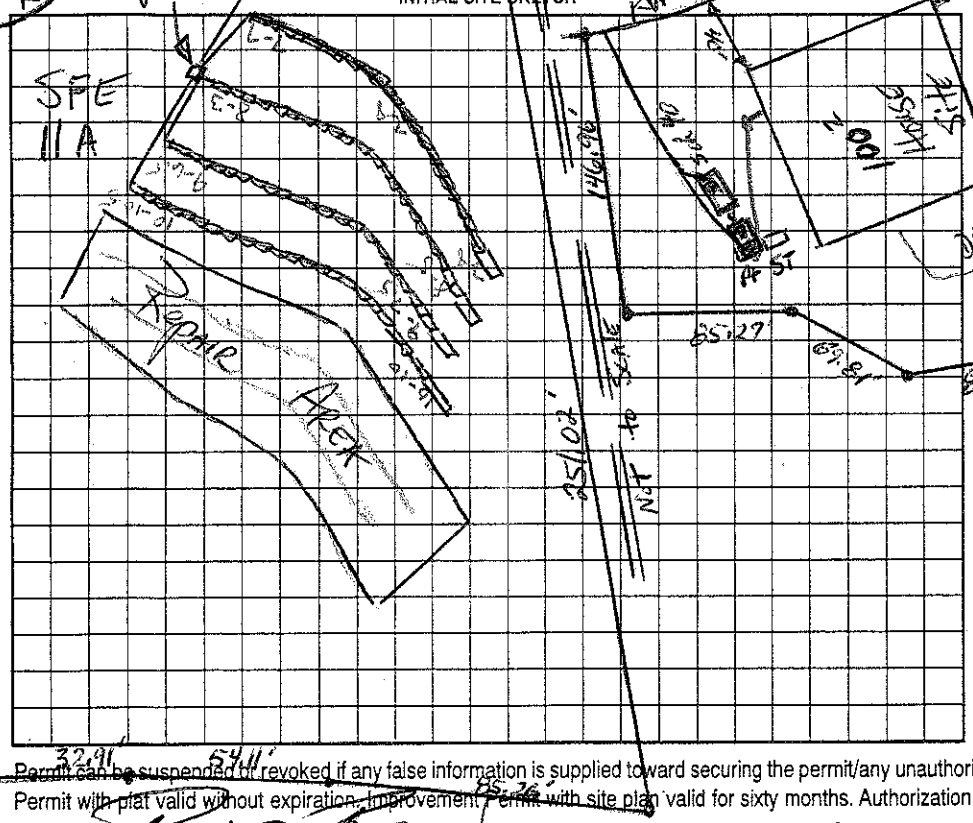

AS BUILT SKETCH

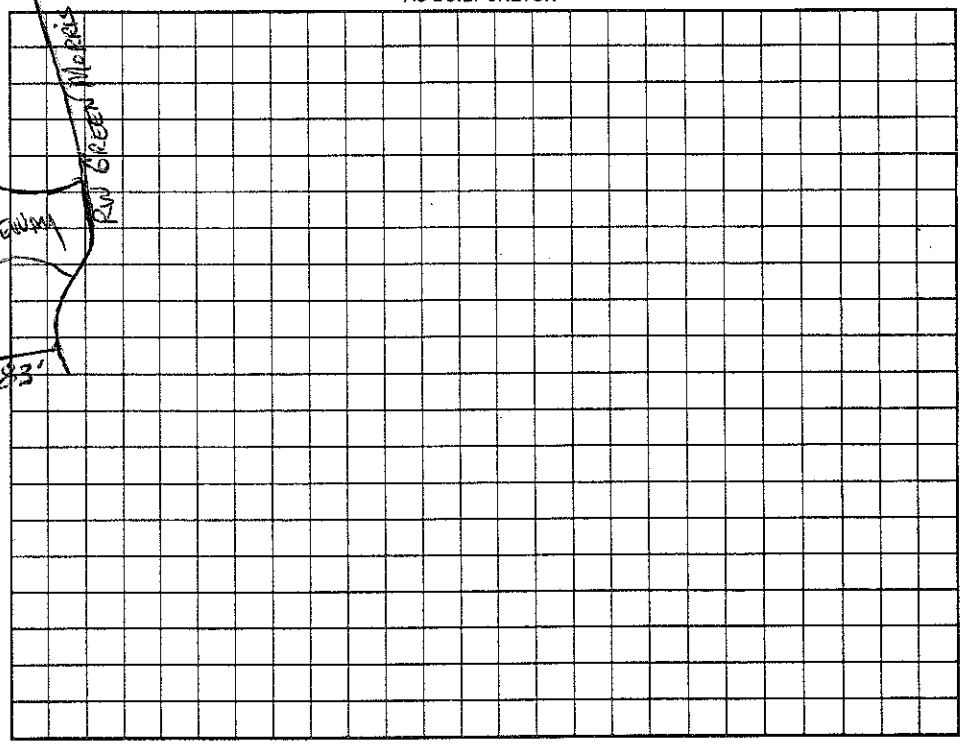

Permit can be suspended or revoked if any false information is supplied toward securing the permit/any unauthorized changes are made to the site/any unauthorized changes are made in the installation of the system. Improvement Permit with plat valid without expiration. Improvement Permit with site plan valid for sixty months. Authorization to Construct is valid for a period equal to that of Improvement Permit – not to exceed sixty months.

Signed: [signature] date 6-21-05 Installed by: Hallmon Const

Improvement Permit by: [signature] date 6-16-03 Operation Permit by: Wesley Sparks R.S. date 6/7/04

Authorization to Construct by: Wesley Sparks R.S. date 12/5/03 Existing System Inspection by: date

HEALTH DEPT. COPY: WHITE OWNER COPY (FINAL): YELLOW OWNER COPY (INITIAL): PINK