ITY HEALTH DEPARTMENT

4626643352 130

STATESVILLE 704-878-5305 MOORESVILLE 704-664-5281

PERMIT / AUTHORIZATION TO CONSTRUCT / OPERATION PERMIT / EXISTING SYSTEM INSPECTION

PIN# 4626-63-7315.18

Crescent Resources LLC for Lake Forest Gtn LLC PHONE: Business _____ Home _____ DATE June 18, 03

P.O. Box 1003, Charlotte, N.C.

Brawley Sch Rd. TR Southfork Turn Right on Agnew TR Green Morris Ln. on left at jct w/ West Callicutt Trail

HOMES BLOCK / SECTION 1 LOT 18 LOT AREA 1.909 AC SITE CLASS PS DESIGN FLOW 480 gpd L.T.A.R. ~.25

Septic Tank: ___ Gallons; STB 400 Date 3/4/05

Pump Tank: ___ Gallons; PT ___ Date ___

Pump Make: ___ Model ___ Serial No. ___

Nitrification Field: No Fields 1 Square Feet 1500 Linear Feet 500

No Lines 5 Trench Width 36" Max Trench Bottom Depth 24" Gravel Depth NA

☑ New System ☐ Repair System Type: I, II, III, IV, V, VI

System Description: Gravity 25% Reduction

Repair System Description: PM/LP 25% Reduction

Maintenance Agreement Required: ☐ Yes ☑ No initially

☐ Slab ☐ Crawl Space ☑ Basement w/plumbing ☐ Basement wo/plumbing

☑ House/Mod. Home ☐ Mobile Home ☐ Business ☐ Other


No. Bedrooms 4 No. Bathrooms 4 No. Employees ___

Water Supply: ☐ Individual ☐ Public ☐ Community

Comments:/Conditions:

1"=50'

INITIAL SITE SKETCH

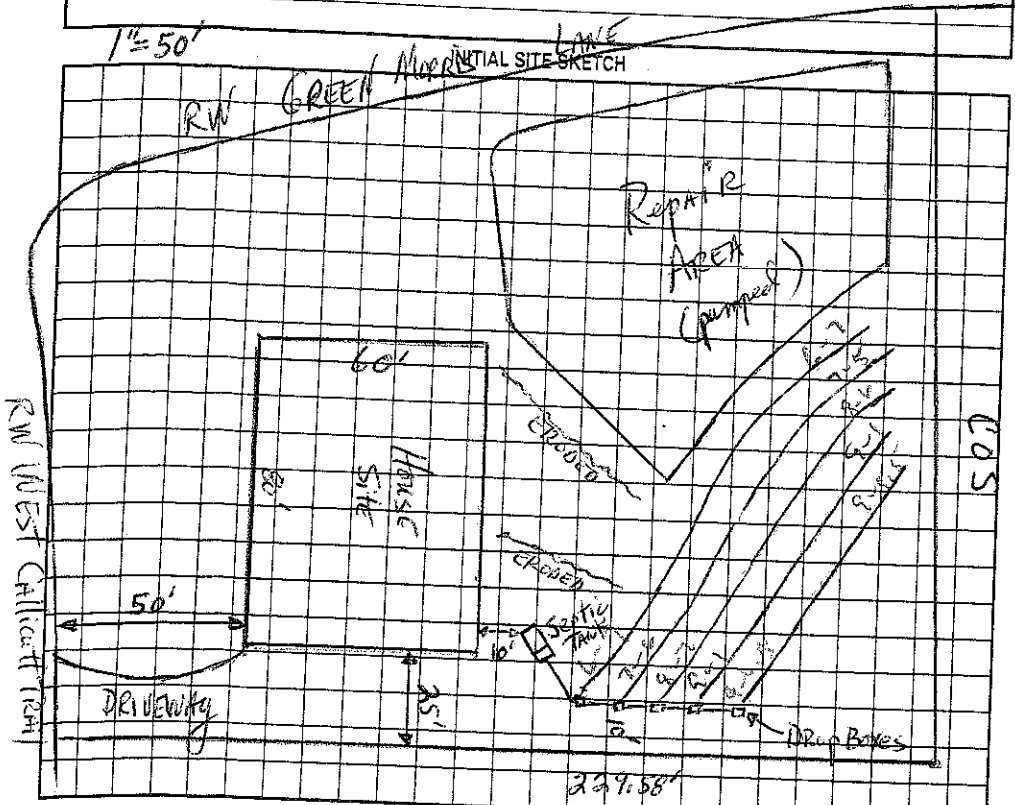

Comments:/Conditions:

AS BUILT SKETCH

Permit can be suspended or revoked if any false information is supplied toward securing the permit/any unauthorized changes are made to the site/any unauthorized changes are made in the installation of the system. Improvement Permit with plat valid without expiration. Improvement Permit with site plan valid for sixty months. Authorization to Construct is valid for a period equal to that of Improvement Permit – not to exceed sixty months.

Signed: _____

Improvement Permit by: _____ date 6-27-03

Authorization to Construct by: _____ date 6-18-03 / 7/11/05

Installed by: _____

Operation Permit by: _____ date 8/26/05

Existing System Inspection by: _____ date _____

HEALTH DEPT. COPY: WHITE OWNER COPY (FINAL): YELLOW OWNER COPY (INITIAL): PINK