IREDELL COUNTY HEALTH DEPARTMENT

STATESVILLE 704-878-5305 MOORESVILLE 704-664-5281

4626645314 130 10

IMPROVEMENT PERMIT / AUTHORIZATION TO CONSTRUCT / OPERATION PERMIT / EXISTING SYSTEM INSPECTION

PERMIT# 111195 PIN# 4626-63-7315.19 DATE June 18,03

OWNER OR CONTRACTOR Grassy Ridge Resources Inc. // Lake Forest Estate LLC / HH2 PHONE: Business 375-5999 Home

ADDRESS P.O. Box 1003, Charlotte, N.C.

LOCATION Brawley School Rd. TR Southlick Bear Right on Agnew TR Green Morris TR West Callicutt 2nd lot on left

SUBDIVISION The Farms BLOCK / SECTION 1 LOT 19 LOT AREA .938 Ac SITE CLASS 1S DESIGN FLOW 480gpd L.T.A.R. .25

Septic Tank: 1000 Gallons; STB 338 Date 2-02-04
Pump Tank: Gallons; PT Date
Pump Make: Model Serial No.
Nitrification Field: No Fields 2 Square Feet 1440 Linear Feet 480
No Lines 2+2 (120'ea) Trench Width 36" Max Trench Bottom Depth 36" Gravel Depth NA

☑ New System ☐ Repair System Type: I, II, III, IV, V, VI
System Description: Conv. w/ 25% Reduction
Repair System Description: Conv. w/ 25% Reduction
Maintenance Agreement Required: ☐ Yes ☑ No


☑ House/Mod. Home No. Bedrooms 4
☐ Mobile Home No. Bathrooms 4
☐ Business No. Employees
☐ Other
☐ Slab ☐ Crawl Space ☑ Basement w/plumbing ☐ Basement wo/plumbing

Water Supply: ☐ Individual ☑ Public ☐ Community

Comments:/Conditions:
* Do not cut drainfield AREA

Comments:/Conditions: Reviewed Building plans & site plan, essentially in compliance with I.P.

INITIAL SITE SKETCH

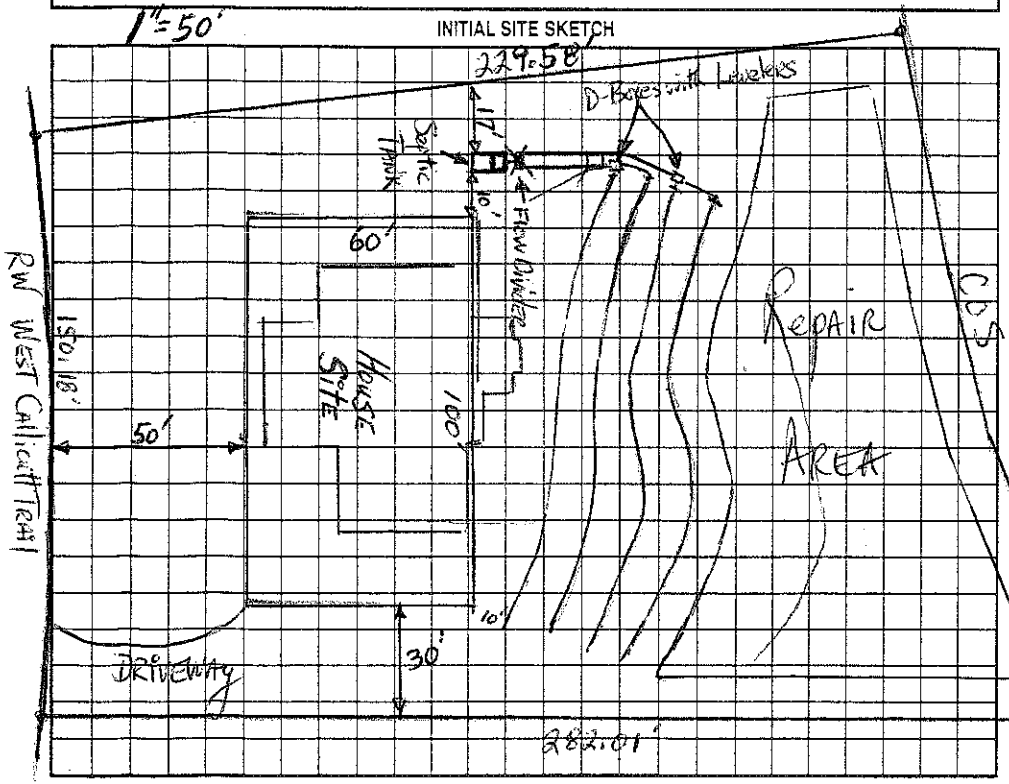

AS BUILT SKETCH

Checked lines 3/26/04
Installed E-Z Flow as Drawn

Permit can be suspended or revoked if any false information is supplied toward securing the permit/any unauthorized changes are made to the site/any unauthorized changes are made in the installation of the system. Improvement Permit with plat valid without expiration. Improvement Permit with site plan valid for sixty months. Authorization to Construct is valid for a period equal to that of Improvement Permit - not to exceed sixty months.

Signed: date 6-27-03 Installed by: Bobby Mayhew

Improvement Permit by: date 6-18-03 Operation Permit by: Maria H. Dotson date 4/6/04

Authorization to Construct by: Maria H. Dotson RS date 11/10/03 Existing System Inspection by: date

HEALTH DEPT. COPY: WHITE OWNER COPY (FINAL): YELLOW OWNER COPY (INITIAL): PINK