IREDELL COUNTY HEALTH DEPARTMENT

STATESVILLE 704-878-5305 MOORESVILLE 704-664-5281

IMPROVEMENT PERMIT / AUTHORIZATION TO CONSTRUCT / OPERATION PERMIT / EXISTING SYSTEM INSPECTION

PERMIT# 100632 PIN# 4626-66-1697 DATE 2/25/06

OWNER OR CONTRACTOR ~~Richard Abernathy~~ Tina Kruger PHONE: Business 704-664-6506 Home

ADDRESS 1397 Brawley Sch. Rd Mooresville NC 28117

LOCATION Brawley Sch, TR McKendree, TR ~~Hogsetty~~ Fulton Farms corner

SUBDIVISION Brook Ridge Shores BLOCK / SECTION ph 1 LOT 2 LOT AREA SITE CLASS. RS DESIGN FLOW 360 L.T.A.R. 0.5

Septic Tank: 1000 Gallons; STB 1007 Date 11-15-06
Pump Tank: Gallons; PT Date
Pump Make: Model Serial No.
Nitrification Field: No Fields 1 Square Feet ~~1200~~ 900 Linear Feet 300
No Lines 4@75' Trench Width 36" Max Trench Bottom Depth 36" Gravel Depth —

☒ New System ☐ Repair System Type: I, II, (III), V, VI
System Description: Gravity 25% Reduction Panel
Repair System Description:
Maintenance Agreement Required: ☐ Yes ☒ No


☒ House/Mod. Home No. Bedrooms 3
☐ Mobile Home No. Bathrooms 2
☐ Business No. Employees
☐ Other
☐ Slab ☒ Crawl Space ☐ Basement w/plumbing ☐ Basement wo/plumbing

Water Supply: ☒ Individual ☐ Public ☐ Community


Comments:/Conditions: Install On Contour - Keep well 100' from Septic System.

Comments:/Conditions: House will Face McKendree

INITIAL SITE SKETCH

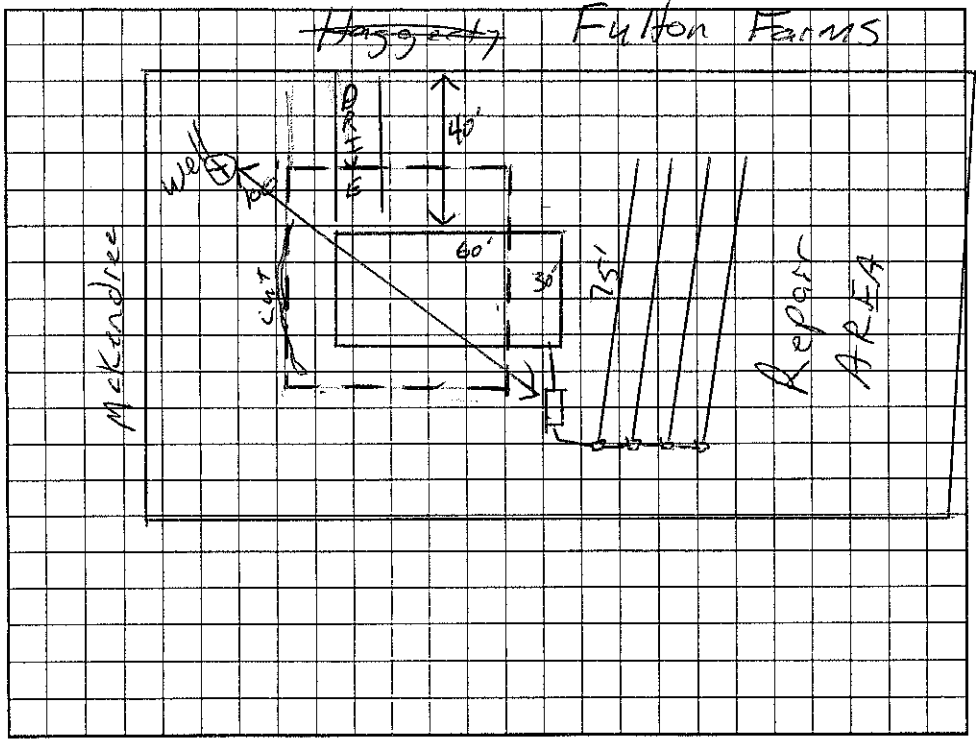

AS BUILT SKETCH

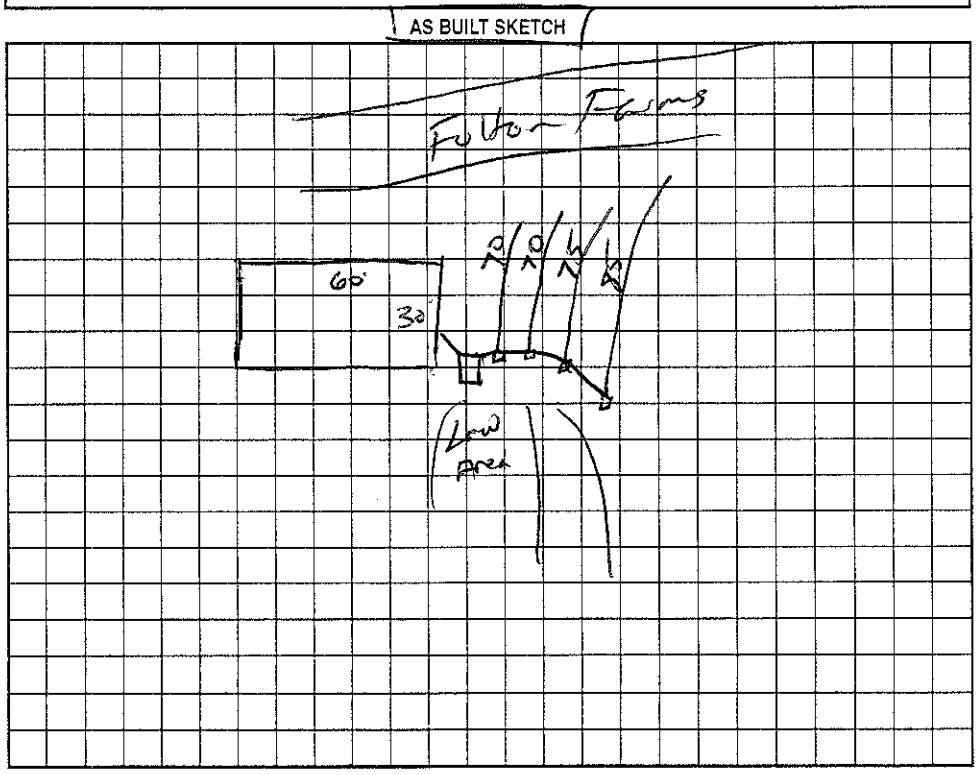

Permit can be suspended or revoked if any false information is supplied toward securing the permit/any unauthorized changes are made to the site/any unauthorized changes are made in the installation of the system. Improvement Permit with plat valid without expiration. Improvement Permit with site plan valid for sixty months. Authorization to Construct is valid for a period equal to that of Improvement Permit – not to exceed sixty months.

Signed: Bart Abernathy date

Installed by: Richard Abernathy

Improvement Permit by: RS date 2/25/06

Operation Permit by: John E Aiken date 2/20/06

Authorization to Construct by: RS date ~~2/25/06~~ 6/13/06

Existing System Inspection by: date

HEALTH DEPT. COPY: WHITE OWNER COPY (FINAL): YELLOW OWNER COPY (INITIAL): PINK