IREDELL COUNTY HEALTH DEPARTMENT

STATESVILLE 704-878-5305 550, Paid MOORESVILLE 704-664-5281

IMPROVEMENT PERMIT / AUTHORIZATION TO CONSTRUCT / OPERATION PERMIT / EXISTING SYSTEM INSPECTION

PERMIT# 133565 PIN# 4626661981 DATE 3-8-06

OWNER OR APPLICANT Richard Abernathy PHONE: Business 704-309-8625 Home 704-664-6506

ADDRESS 1397 Brawley School Rd Mooresville 28117

LOCATION Brawley school Rd TR McKendree TR Hagerty on left 121 Evitan Farms

SUBDIVISION Brookridge Shores BLOCK / SECTION ____ LOT 1 LOT AREA .47 Ac SITE CLASS. PS DESIGN FLOW 360gpd L.T.A.R. .25gpd/ft²

Septic Tank: 1000 Gallons; STB ~~1000~~ 1250 Date 10-20-05

Pump Tank: 1000 Gallons; PT 27 Date 10-6-05

Pump Make: ____ Model ____ Serial No. ____

Nitrification Field: No Fields 1 Square Feet 1440 Linear Feet 240

No Lines 4 Trench Width 24" Max Trench Bottom Depth 36"

☒ New System ☐ Repair ☐ Expansion System Type: I II III (IV) V VI

System Description: LP Panel

Repair System Description: LP Panel

Maintenance Agreement Required: ☒ Yes ☐ No

☒ House/Mod. Home No. Bedrooms 3

☐ Mobile Home No. Persons ____

☐ Business No. Employees ____

☐ Other ____

Water Supply: ☒ Individual ☐ Public ☐ Community


Gravel Depth N/A ☐ Gravity ☒ Pressure ☐ Slab ☒ Crawl Space ☐ Basement w/plumbing ☐ Basement wo/plumbing

Comments:/Conditions: Surface Intercept Drain placed inside back PL graded in V shape with 1% fall Tanks may be placed behind house if meet rules Install 5lo panels

Comments:/Conditions: -If tanks moved may reverse drive

1" = 50'

INITIAL SITE SKETCH

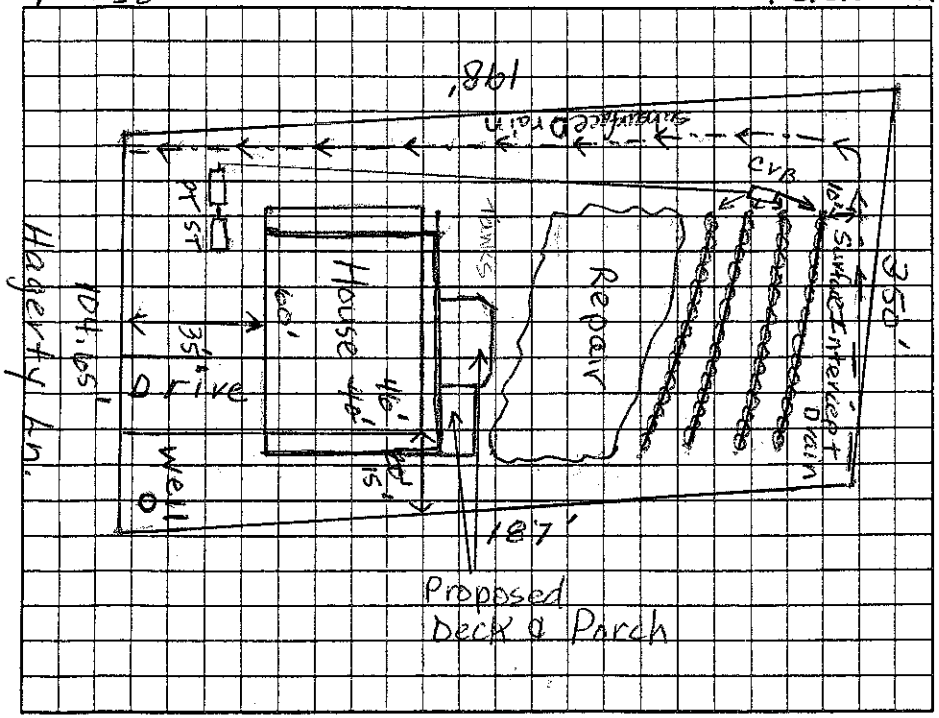

AS BUILT SKETCH

ICHD-Environmental Health Division

The proposed / existing Deck & Porch addition does not appear to impact the existing septic system.

**NOTE: Foundation shall be min. 5' from Tanks & Repair

Judy Melville R.S.

Date: 7-11-12

ICHD Environmental Health Division

Permit can be suspended or revoked if any false information is supplied toward securing the permit/any unauthorized changes are made to the site/any unauthorized changes are made in the installation of the system. Improvement Permit with plat valid without expiration. ☐ Improvement Permit with site plan valid for sixty months ☒ Authorization to Construct is valid for a period equal to that of Improvement Permit – not to exceed sixty months.

Signed: Robyn B. Abernathy date 03-17-06

Improvement Permit by: Judy Melville date 3-8-06

Authorization to Construct by: Judy Melville date 5-11-06

Installed by: Richard Abernathy

Operation Permit by: John E Allen date 1/25/07

Existing System Inspection by: ____ date ____

HEALTH DEPT. COPY: WHITE OWNER COPY (FINAL): YELLOW OWNER COPY (INITIAL): PINK

17' bottom Repair to