IREDELL COUNTY HEALTH DEPARTMENT

STATESVILLE 704-878-5305 130.00 Paid MOORESVILLE 704-664-5281

IMPROVEMENT PERMIT / AUTHORIZATION TO CONSTRUCT / OPERATION PERMIT / EXISTING SYSTEM INSPECTION

PERMIT# 126133 PIN# 4626-66-2468 DATE 2/14/05

OWNER OR CONTRACTOR Bart Abernathy PHONE: Business 704-309-8626 Home 704-664-4318

ADDRESS 1397 Brawley School Rd Mooresville NC 28117

LOCATION BSR, TR McKendree, TR ~~Hagerty~~ Fulton Lt Near End

SUBDIVISION Brookridge Shores BLOCK / SECTION ~~2~~ 6 LOT 62 LOT AREA 0.47 AC SITE CLASS. PS DESIGN FLOW 360 L.T.A.R. 0.3

Septic Tank: 1000 Gallons; STB 283 Date 10-10-06

Pump Tank: 1000 Gallons; PT 794 Date 10-11-01

Pump Make: Goulds Model PE31 Serial No.

Nitrification Field: No Fields 1 Square Feet 900 Linear Feet 300

No Lines 4@75' Trench Width 36" Max Trench Bottom Depth 36" Gravel Depth —

☒ New System ☐ Repair System Type: I, II, (III), IV, V, VI

System Description: PM 25% Reduction

Repair System Description: Paul Block

Maintenance Agreement Required: ☐ Yes ☒ No

☒ House/Mod. Home ☐ Mobile Home ☐ Business ☐ Other

No. Bedrooms 3 No. Bathrooms 3 No. Employees

☐ Slab ☒ Crawl Space ☐ Basement w/plumbing ☐ Basement wo/plumbing

Water Supply: ☒ Individual ☐ Public ☐ Community


Comments:/Conditions:

Do not cut for house site

1" = 40'

Comments:/Conditions:

INITIAL SITE SKETCH

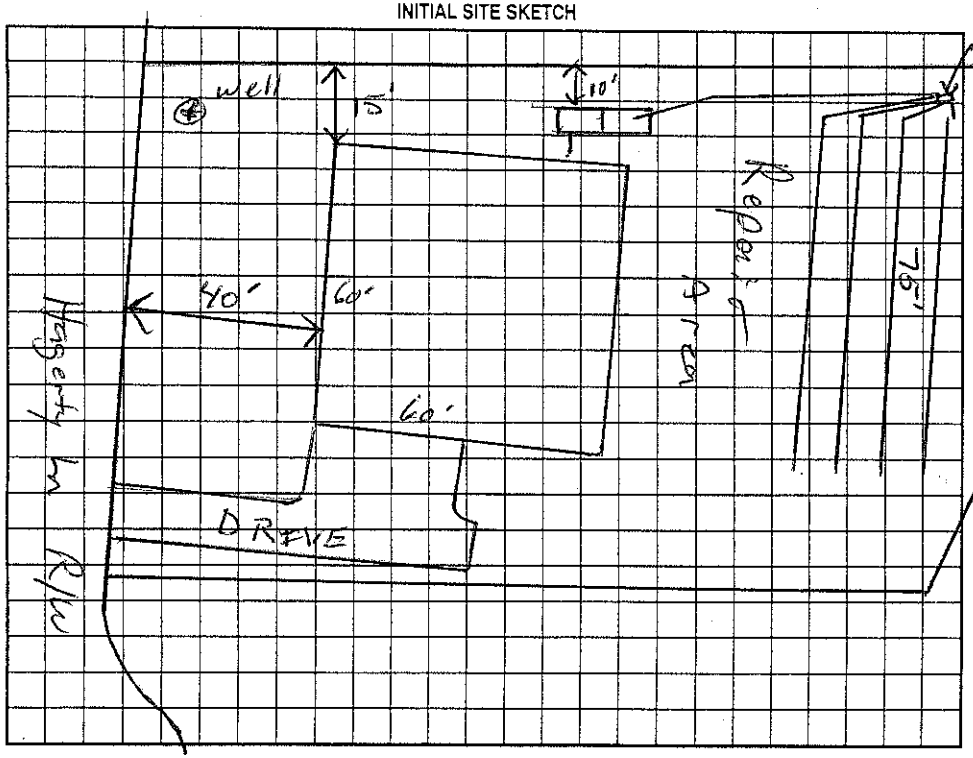

AS BUILT SKETCH

Permit can be suspended or revoked if any false information is supplied toward securing the permit/any unauthorized changes are made to the site/any unauthorized changes are made in the installation of the system. Improvement Permit with plat valid without expiration. Improvement Permit with site plan valid for sixty months. Authorization to Construct is valid for a period equal to that of Improvement Permit – not to exceed sixty months.

Signed: Bart Abernathy date 2-15-05 Installed by: Abernathy

Improvement Permit by: RS date 2/14/05 Operation Permit by:

Authorization to Construct by: RS date 2/14/05 Existing System Inspection by: RS date 6/6/07

HEALTH DEPT. COPY: WHITE OWNER COPY (FINAL): YELLOW OWNER COPY (INITIAL): PINK